

WALL PANELS_ FRONT ELEVATION
1:20

ECOPHON - AKUSTO ONE 1192 X 592 WALL PANELS


AGENT: Mark Le Grange
072 380 6019
Mark.LeGrange@saint-gobain.com

3 Panels per room - 20 rooms x 3 = 60 Panels

2 per box = 30 boxes required

- 20 boxes colour Oyster
- 4 boxes Acai
- 4 boxes Tangerine
- 2 boxes Ginger

Each room 2x colour Oyster & 1x alternate colour

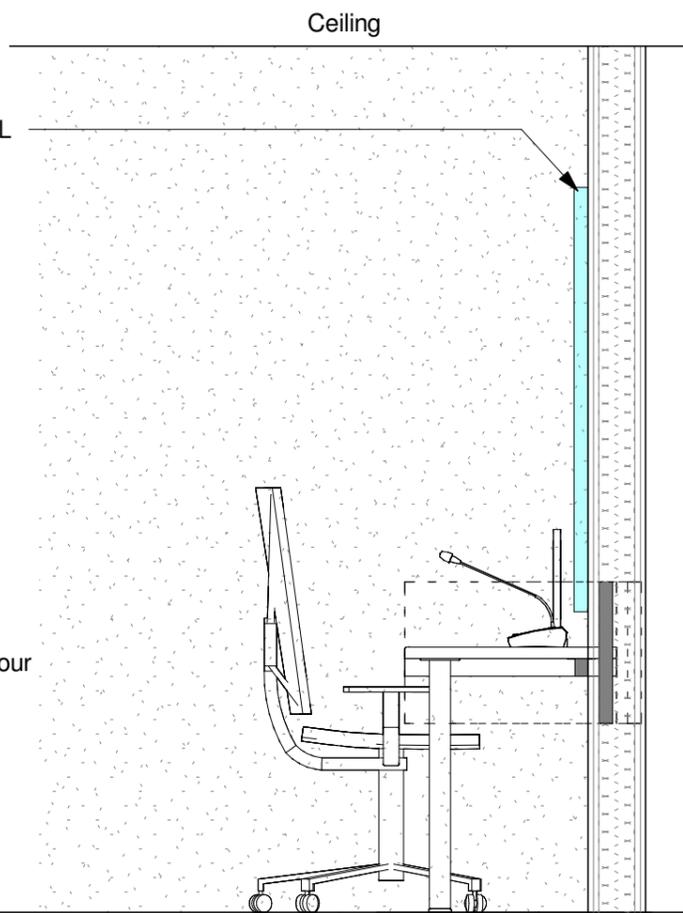

WALL PANELS_ SIDE ELEVATION
1:20

INTERPRETING ROOMS_ 5TH FLOOR
1 : 20

AS-BUILT

DBSA
DEVELOPMENT BANK OF SOUTHERN AFRICA
Building Africa's Prosperity

DURAPI
CONSULTING

ruben reddy architects

Durban | Johannesburg | Cape Town | Bloemfontein | Polokwane
info@rubenreddyarch.co.za | www.rubenreddyarch.co.za

REV	DESCRIPTION	DATE
0	ISSUED FOR CONSTRUCTION	2023.08.04
1	ROOM DATA_INTERPRETING ROOMS_ PANEL COLOURS AMENDED	2023.08.16

109_WP A.3 - Temporary Offices For Members			
DESIGNED	DRAWN	CHECKED	APPROVED
RP	RJ	RP	RP
INTERPRETING ROOMS_5TH FLOOR			

TIME STAMP: 2023/12/12 15:51:27

1 : 20 @ A3

INFORMATION	L.A SUBMISSION	TENDER	CONSTRUCTION
PROJECT NUMBER	ZONE	STAGE	ISSUE DATE
109	A00	CON	2023.12.12
DRAWING NUMBER			REVISION
109-RRR-A00-00-04.00.009			1
PROJECT NO.	ORIG.	ZONE	LEVEL TYPE DIS.
			SHEET NO.