


1. OFFICE DEMISING PARTITIONS ARE TO CENTRE LINE OF WINDOW MULLIONS
2. DIMENSIONS ARE INDICATIVE ONLY

PLEIN STREET

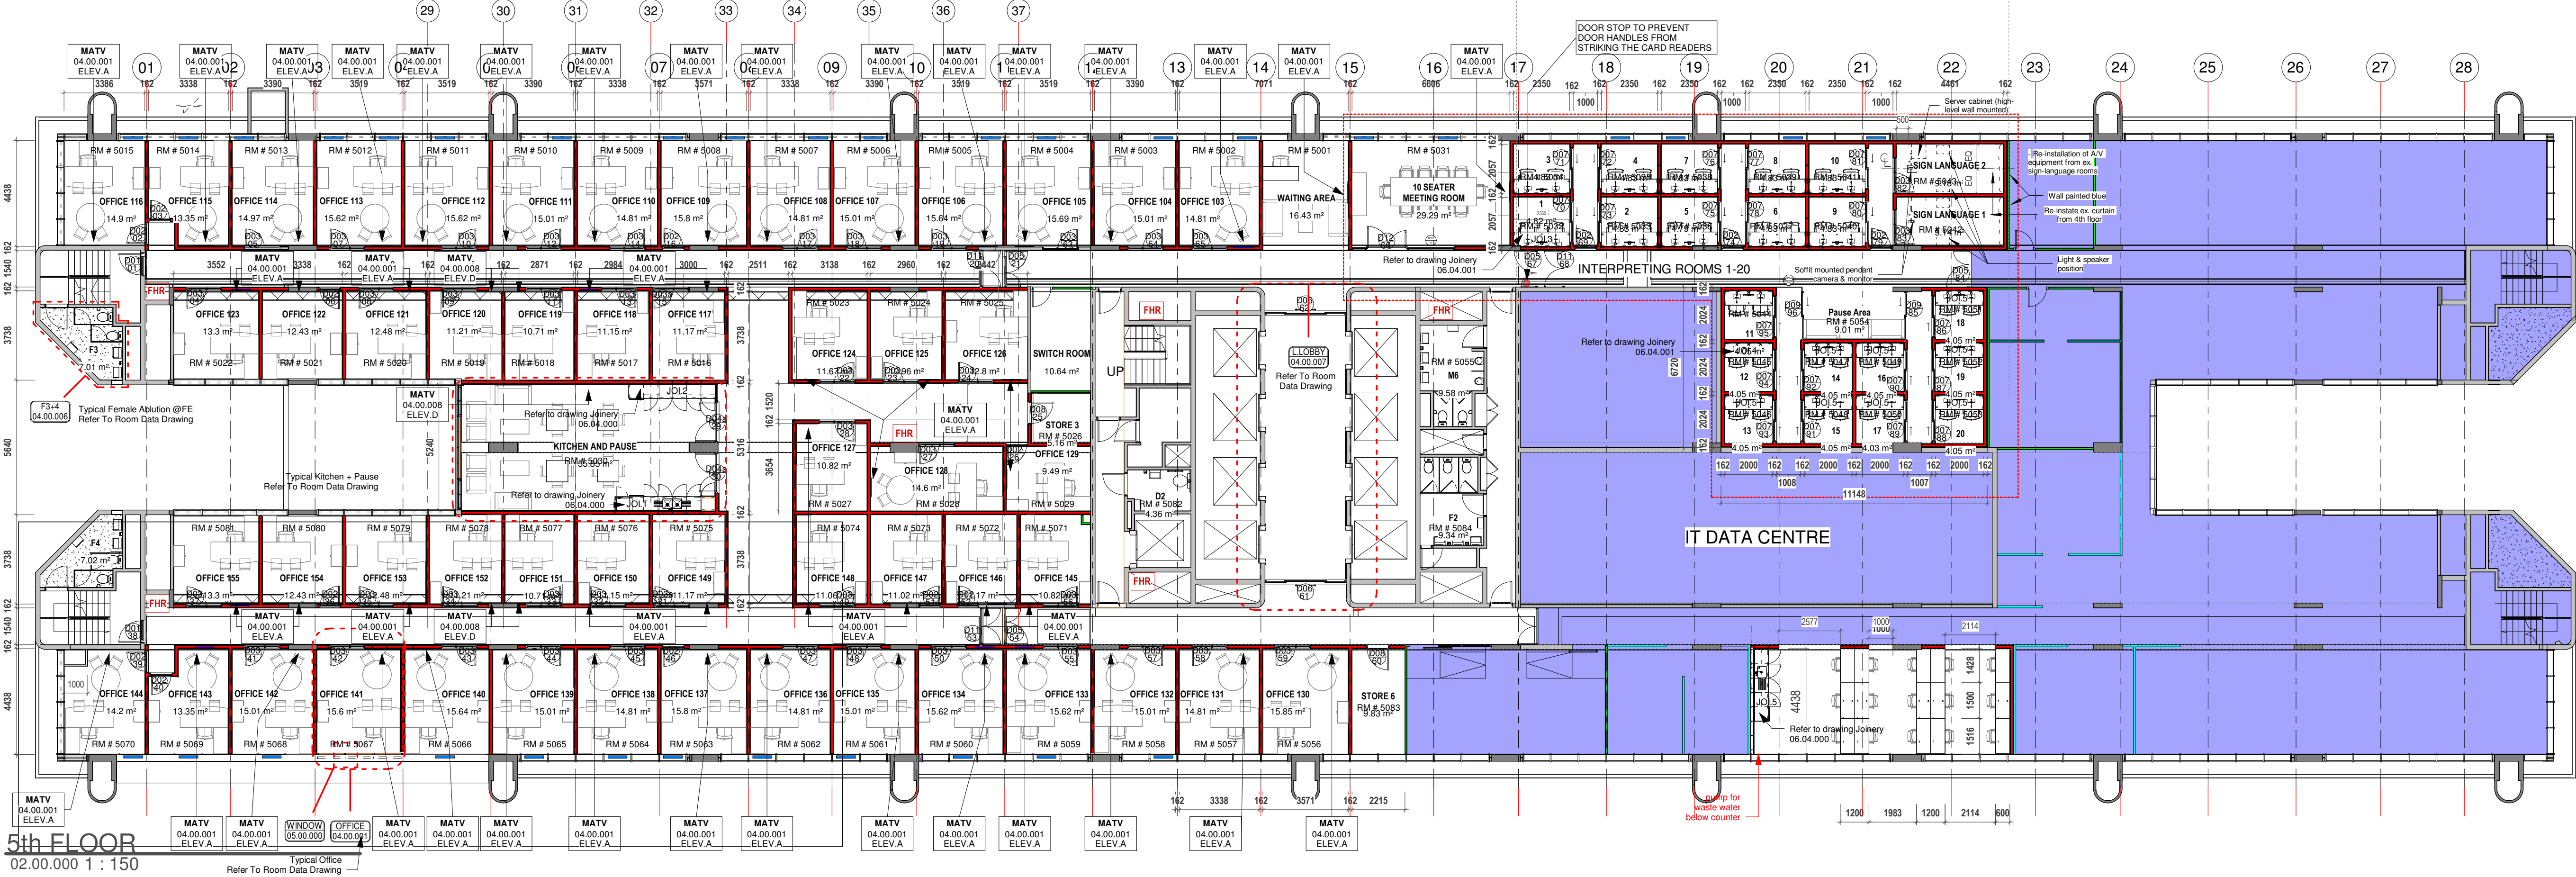

5th FLOOR
02.00.000 1 : 150

REV	DESCRIPTION	DRAWN	DATE
0	ISSUED FOR CONSTRUCTION		2023.05.30
1	LOCATIONS OF MATV		2023.07.24
2	FLOOR LAYOUT 5th FLOOR, INTERPRETING ROOMS: 11+12(SIGN LANGUAGE), D03-D03-43 MOVED FLUSH WITH WALL TO ACCOMMODATE EQUIPMENTS		2023.07.28
3	ADDITIONAL DOOR TYPE D03a @4TH FLOOR, OFFICE 15 AND 5TH FLOOR, OFFICE 117, REDUCING DOOR TYPE D03 TO 5760		2023.08.01
4	FLOOR LAYOUT OFFICE 59 AND 96, D03 CHANGED D02, D03-LEFT HANDED 23no & RIGHT HANDED 56no, D02-LEFT HANDED 20no & RIGHT HANDED 22no		2023.08.15
5	D10 - GATE SWING CHANGED		2023.08.17
6	4TH-5TH FLOOR LAYOUTS + DOOR SCHEDULE, OFFICES 70(4TH)&149(5TH) TO BE FITTED WITH D03a.		2023.09.13
7	4TH FLOOR LAYOUT, EXISTING SERVICE DUCTS/OFFICES 12, 53, 82, 89		2023.11.17
8	ROOM NO. ADDED & ROOM NAMES CHANGED		2023.11.21
9	3X DOOR STOPPERS ADDED		
10	REVISED DESK ORIENTATION		

NEW WALLS LEGEND

New 89mm Gyproc Classic Wall System, Or Similar Approved (30min And 420b).
To Manufacture's Specification And Details.

New Wall Height To Underside Of Existing Ceiling

Existing Half Height Drywall + 300mm Glazing Insert.

Existing Full Height Drywall + Glazing & Doors.

Demolished Walls.

NEW FLOOR FINISHES LEGEND


Belgotex, Hard Graft 300 x 1200 x 7, General Medium Commercial, Stainproof Miracle Fibre, Tufted Multi scroll loop pile. Plank carpet tile.
Colours: Shaded: Hype

Brick Ashlar pattern

Passages
Offices

Area Schedule = 98m²

New 162mm GYPROC FIRE RESISTANT WALL SYSTEM, OR SIMILAR APPROVED (120min and 540b).
BOARD TYPE: STUD AND INSULATION TO MANUFACTURE'S SPECIFICATION AND DETAILS

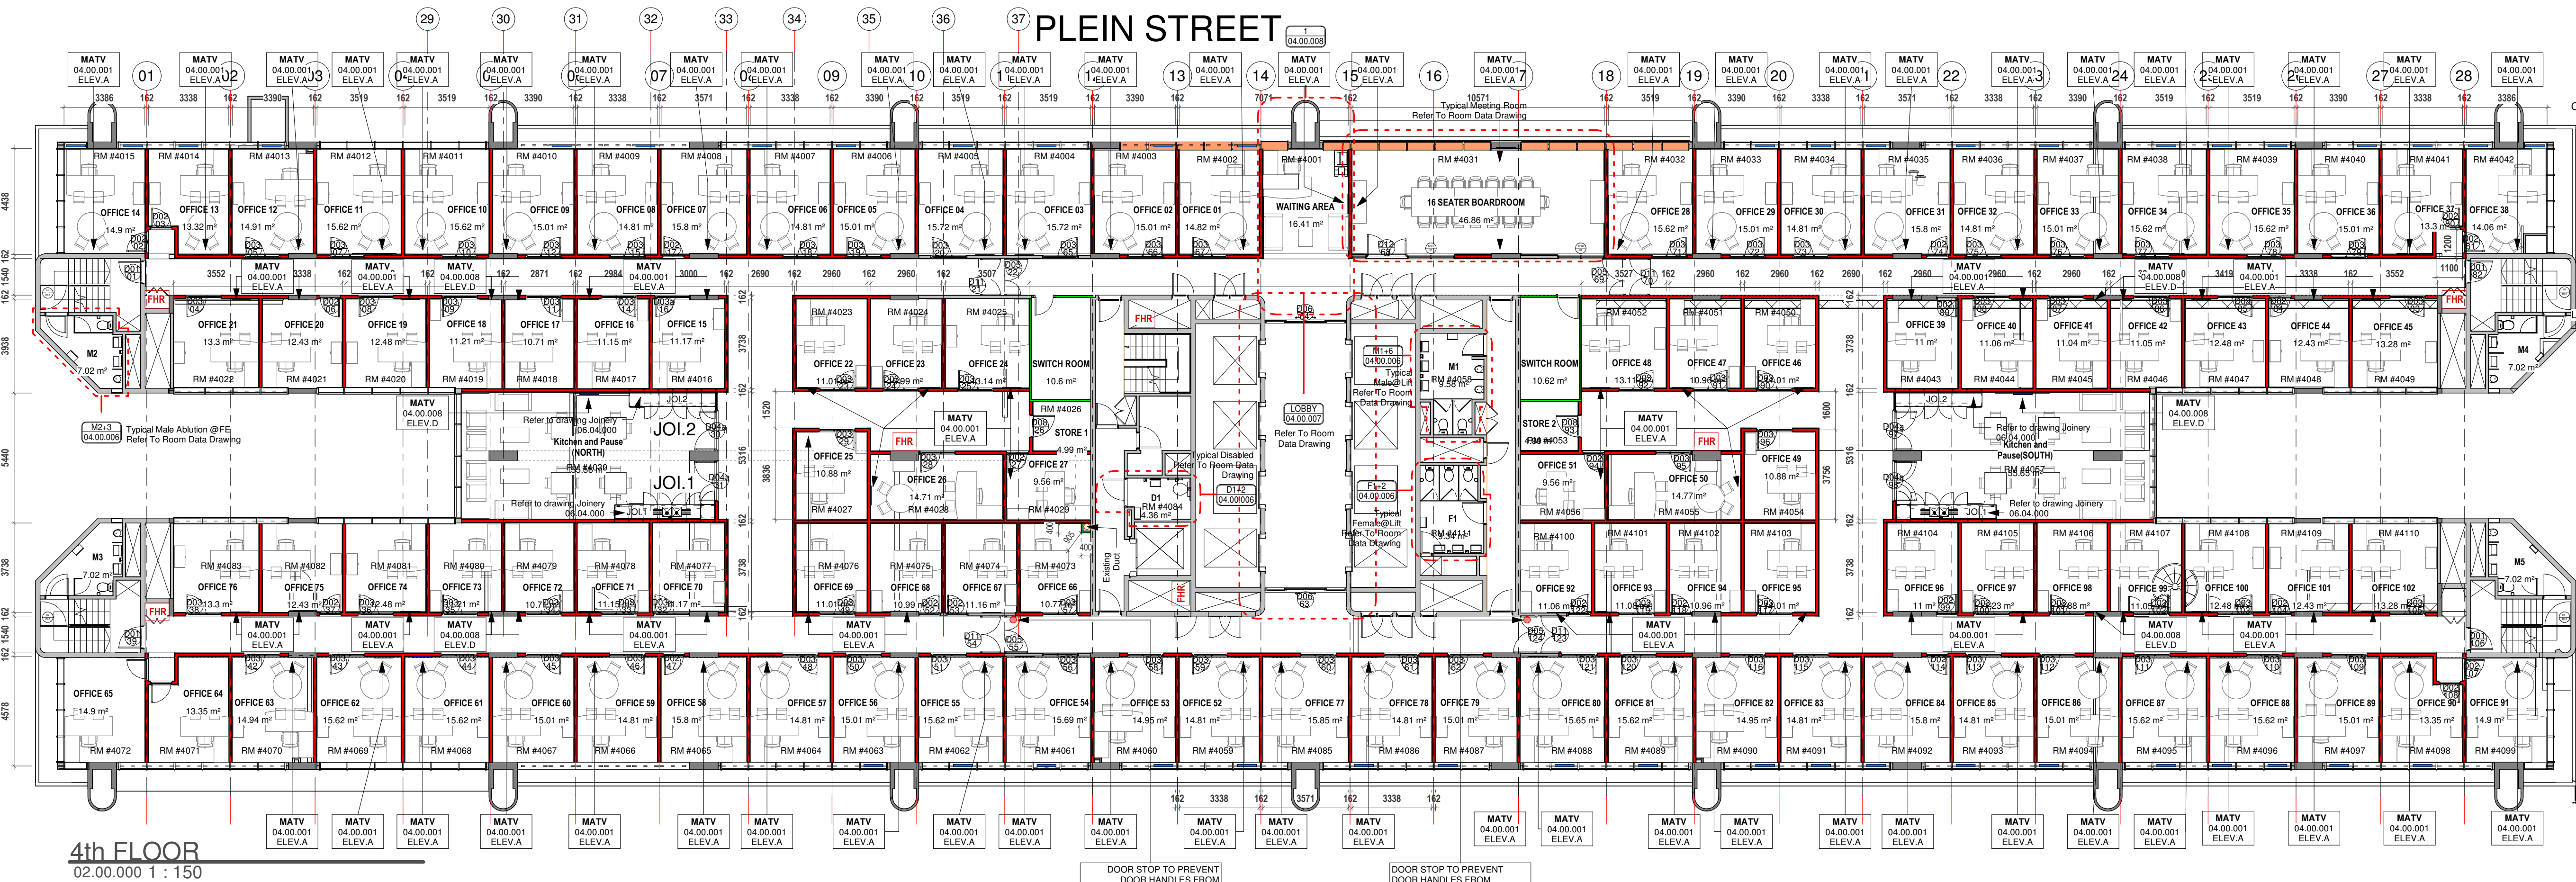

4th FLOOR
02.00.000 1 : 150

CLIENT: **DBSA**
DEVELOPMENT BANK OF SOUTHERN AFRICA
Building Africa's Prosperity

LEAD CONSULTANT: **DARAPI CONSULTING**
ruben reddy architects
Durban | Johannesburg | Cape Town | Bloemfontein | Polokwane
info@rubenreddy.co.za | www.rubenreddy.co.za

109_WP A.3 - Temporary Offices For Members
4th & 5th Flr. 90 Plein Street

DESIGNED RP
DRAWN RJ/KP/JVE
CHECKED RP
APPROVED RP

FLOOR LAYOUTS 4th & 5th FLOORS

TIME STAMP: 2023/12/12 09:55:22						As indicated @ A1	
INFORMATION		LA SUBMISSION		TENDER		CONSTRUCTION	
PROJECT NUMBER		ZONE		STAGE		ISSUE DATE	
109		A00		CON		2023-12-12	
DRAWING NUMBER							REVISION
109-RRR-A00-00-DR-01.00.000							10
PROJECT NO.	ORIG.	ZONE	LEVEL	TYPE	DATE	SHEET NO.	
109-RRR-A00-00-DR-01.00.000	001	A00	001	CON	2023-12-12	10	

AS-BUILT