


AS-BUILT

STORE ROOM DOOR -
ACCESS CONTROL

D08

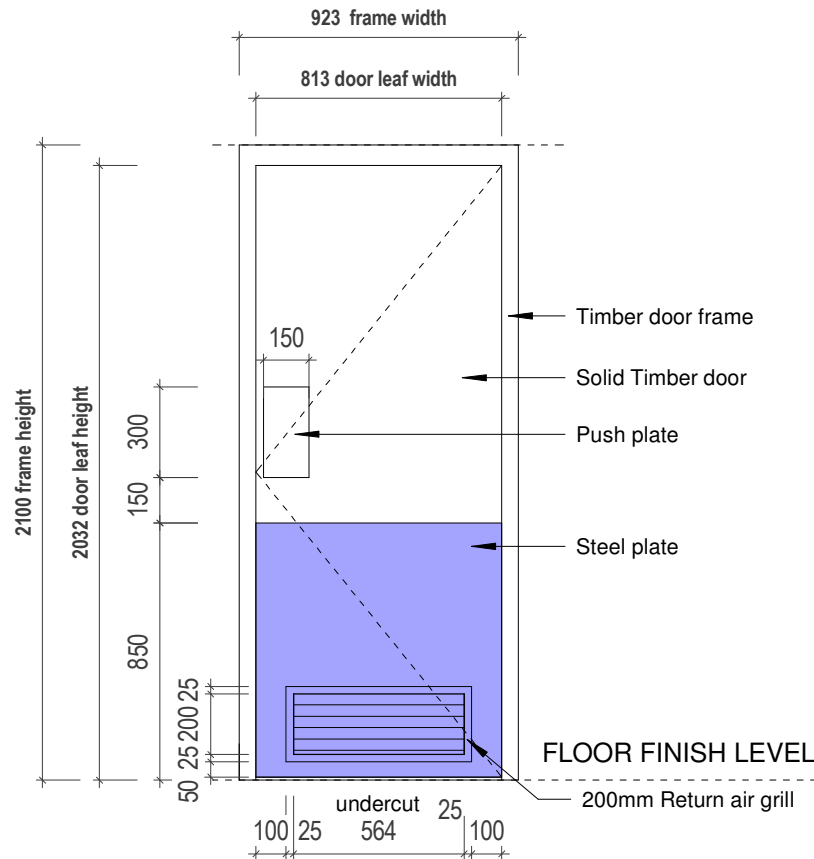

DESCRIPTION	:	Solid timber door
FRAME	:	Timber door frame
HINGES	:	Refer to ironmongery schedule.
GLAZING	:	N/A
IRONMONGERY	:	Refer to ironmongery schedule.
SIGNAGE	:	N/A
NO.	:	Inside Opening 3no. Left Handed Door Inside Opening 1no. Right Handed Door

GENERAL NOTES

Door swings and positions to be calculated from the door reference plans.
All dimensions are to be checked on site by the contractor prior to construction.
Any discrepancies on this drawing are to be reported to the office of the architect prior to construction.
All aluminium and steel is to be isolated from one another to prevent galvanic action.
All quantities are to be checked on site by the contractor prior to placing orders.
All undercutting of doors is to be calculated from mechanical detailed construction drawings.
All shop front doors are to be AAAMSA approved.

COPYRIGHT NOTE

This drawing is subject to copyright and may not be reproduced, in whole or part, or in any manner whatsoever without written permission from the architect

 **ruben reddy architects**

2nd-3rd floors / 110 Long Street / Cape Town / South Africa
8001 / Tel: +27(0)21 426 0969 / Fax: +27(0)21 424 5323

Client:

DBSA
DEVELOPMENT BANK OF SOUTHERN AFRICA
Building Africa's Prosperity

Lead:

DUPATI
CONSULTING

Drawing No.: 06.01.008

Scale: 1 : 25

Date issued: 2023.12.12

Drawn: KP

Rev.: 1