

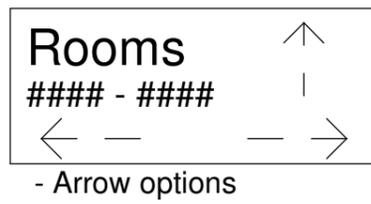


Type 5

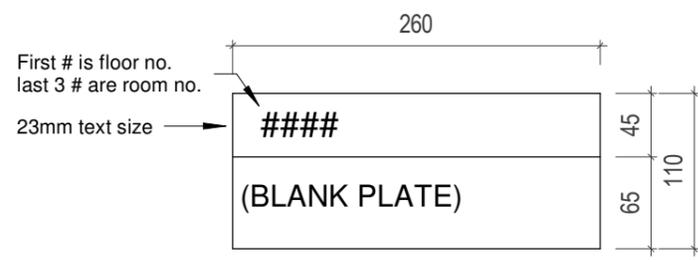

Type 8

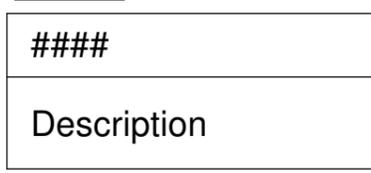

DESCRIPTION:

MATERIAL: ALUMINIUM - BRUSHED GOLD


FINISH: BLACK VINYL LETTERING

FONT: Arial Bold


FIXING: VARIES: FIXED TO DRYWALL; ADHERED TO GLASS WITH BACK-PLATE & FIN SIGN PERPENDICULAR TO WALL.

TYPICAL DOOR SIGNAGE DETAIL
1 : 5


Type 7

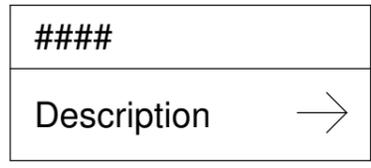


Type 6

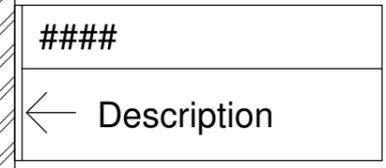

Type 9

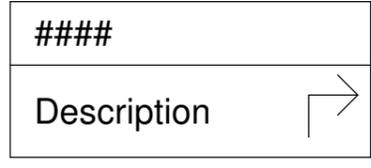

Type 10

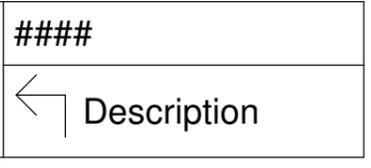

SIGN TYPES
1 : 5



FINISH



CONFIGURATION SIGN TYPE 8

- SIGNS WILL ALWAYS BE PLACED ON WALL NEXT TO DOOR UNLESS OTHERWISE INDICATED (BOARDROOMS).
- DOOR SIGNS FOR THE INTERPRETATING ROOMS ARE PLACED WHERE INDICATED ON PLAN.
- FOR ALL DOOR SIGN TYPES, REFER TO SCHEDULE.

AS-BUILT

REV	DESCRIPTION	DATE
0	ISSUED FOR CONSTRUCTION	2023.06.26
1	SIGNAGE DETAILS UPDATED	2023.07.18
2	SIGNAGE INFORMATION UPDATED	2023.09.13

109_WP A.3 - Temporary Offices For Members			
DESIGNED	DRAWN	CHECKED	APPROVED
RP	JVE	RP	RP

TIME STAMP: 2023/12/12 12:43:04 1 : 5 @ A3

INFORMATION	L.A SUBMISSION	TENDER	CONSTRUCTION
PROJECT NUMBER	ZONE	STAGE	ISSUE DATE
109		CON	2023-12-12
DRAWING NUMBER			REVISION
109-RRR-DR-05.01.001			2
PROJECT NO.	ORIG.	ZONE	LEVEL TYPE DIS. SHEET NO.