



JOINERY 1 - KITCHEN 4TH&5TH FLOORS
 1:20

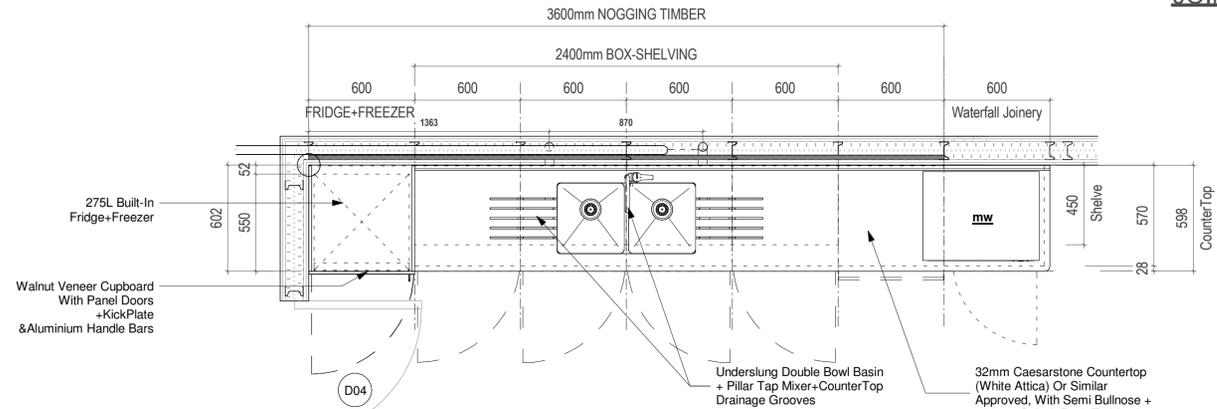

JOINERY 1 _ FLOOR PLAN
 1:20

JOINERY QUANTITY
JOI. 1 = 1x @ 5th Floor
2x @ 4th Floor
JOI. 2 = 1x @ 5th Floor
2x @ 4th Floor

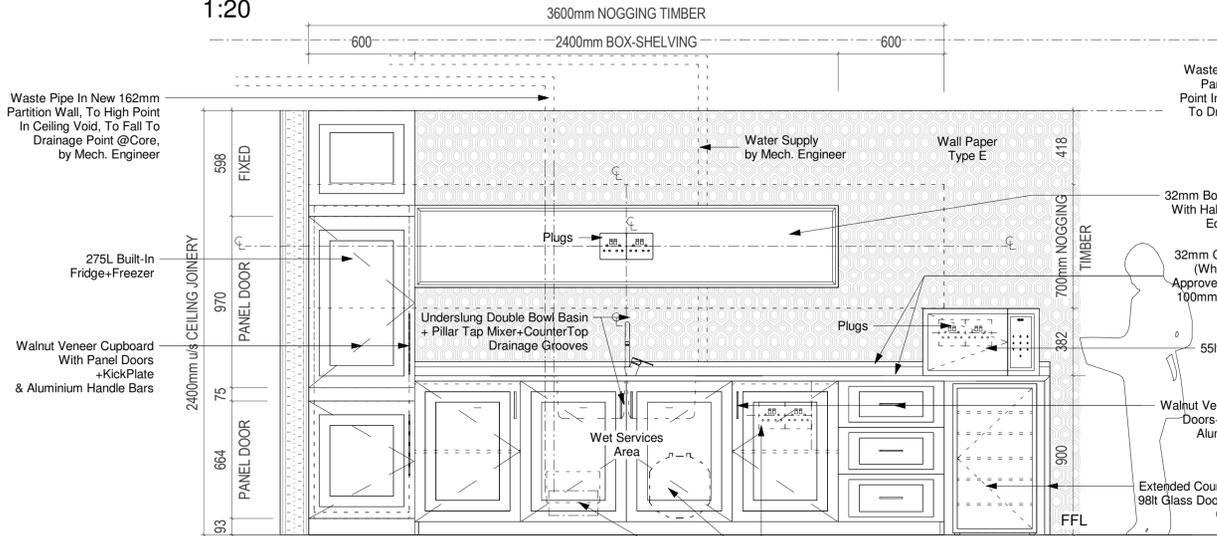

JOINERY 1 _ FRONT ELEVATION
 1:20

JOINERY 1 _ SIDE ELEVATION
 1:20




3D_JOINERY 1


CLIENT:

DBSA
 DEVELOPMENT BANK OF SOUTHERN AFRICA
Building Africa's Prosperity
 LEAD CONSULTANT:
DURAPI
 CONSULTING

JOINERY 2 - KITCHEN 4TH&5TH FLOORS
 1:20

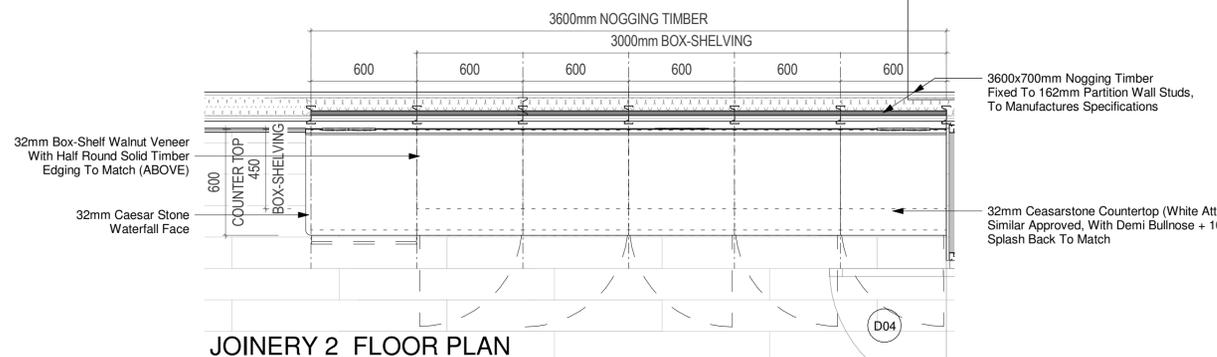

JOINERY 2_FLOOR PLAN
 1:20

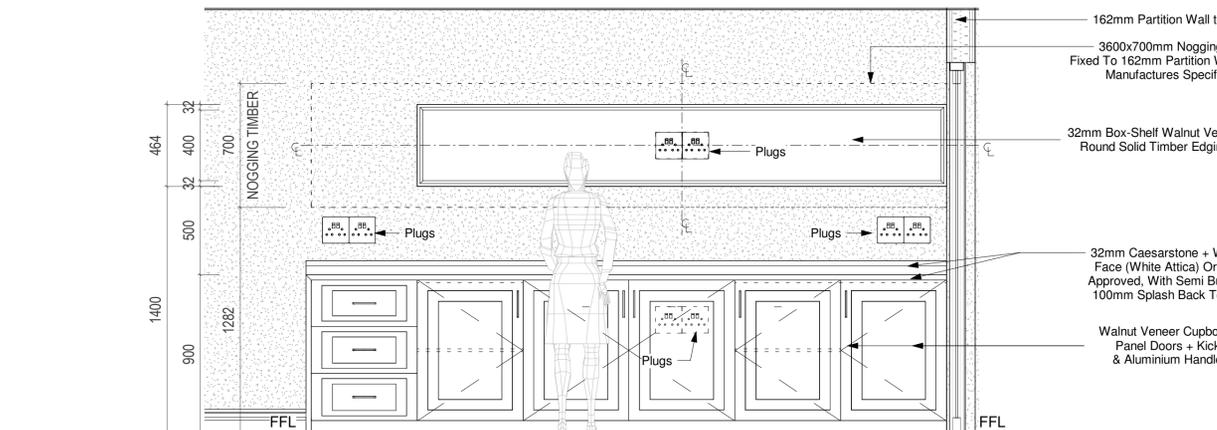

JOI. 2_FRONT ELEVATION
 1:20

JOI. 2_SIDE ELEVATION
 1:20



3D_JOINERY 2

ruben reddy architects
 Durban | Johannesburg | Cape Town | Bloemfontein | Polokwane
 info@rubenreddy.co.za | www.rubenreddy.co.za

109_WP A.3 - Temporary Offices For Members
 4th & 5th Flr_90 Plein Street

DESIGNED RP	DRAWN JN	CHECKED RP	APPROVED RP
----------------	-------------	---------------	----------------

JOINERY 1 & 2
 4th & 5th FLOORS

AS-BUILT

TIME STAMP: 2023/12/12 12:45:28	1:20 @ A1		
INFORMATION	LA SUBMISSION	TENDER	CONSTRUCTION
PROJECT NUMBER	ZONE	STAGE	ISSUE DATE
109		CON	2023-12-12
DRAWING NUMBER			REVISION
109-RRR-SH-06.04.000			0

ISO A1 840mm x 594mm