

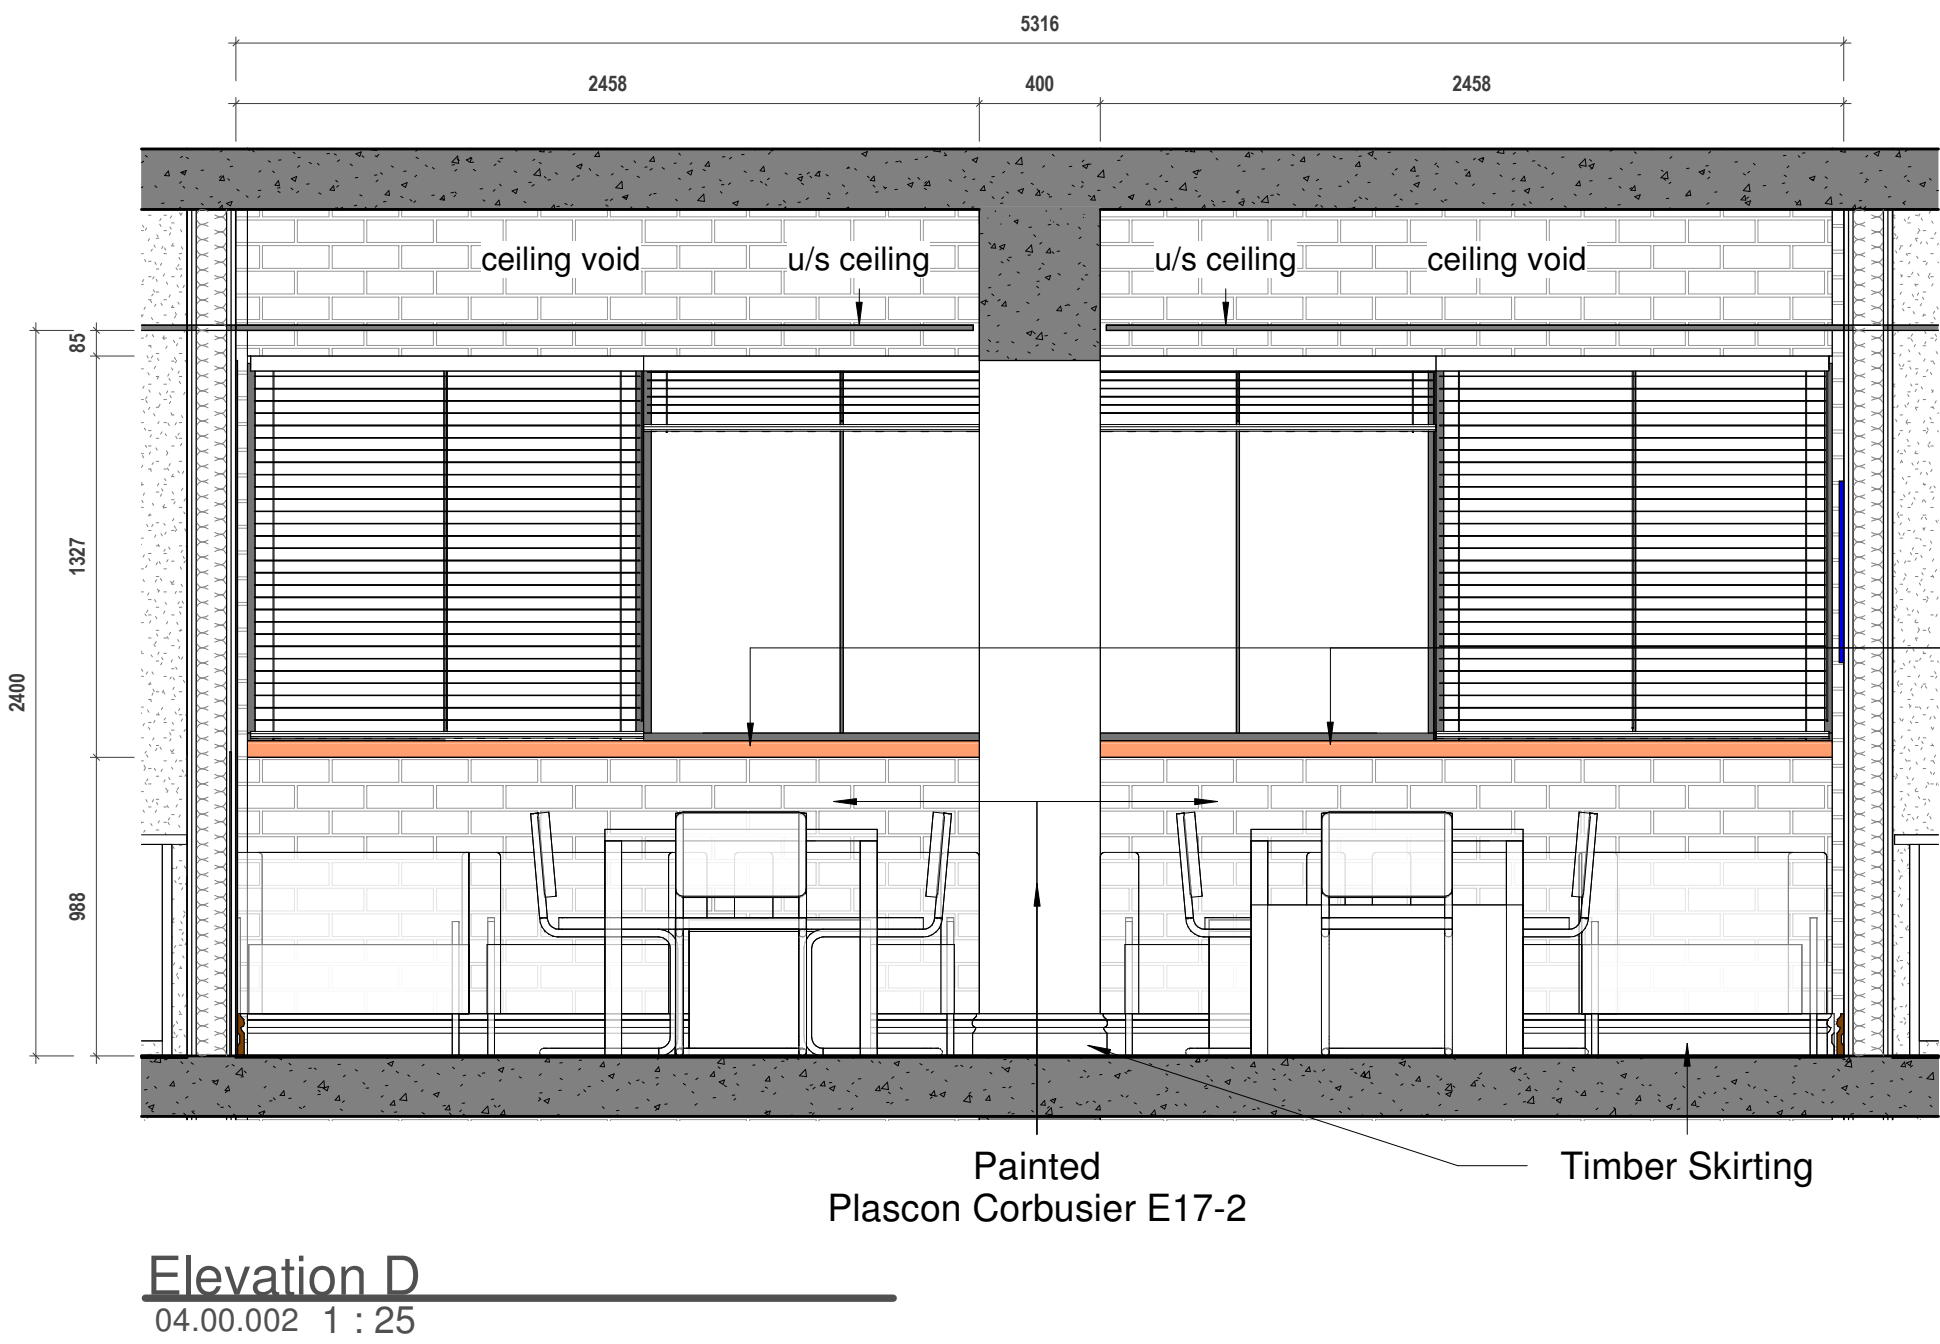
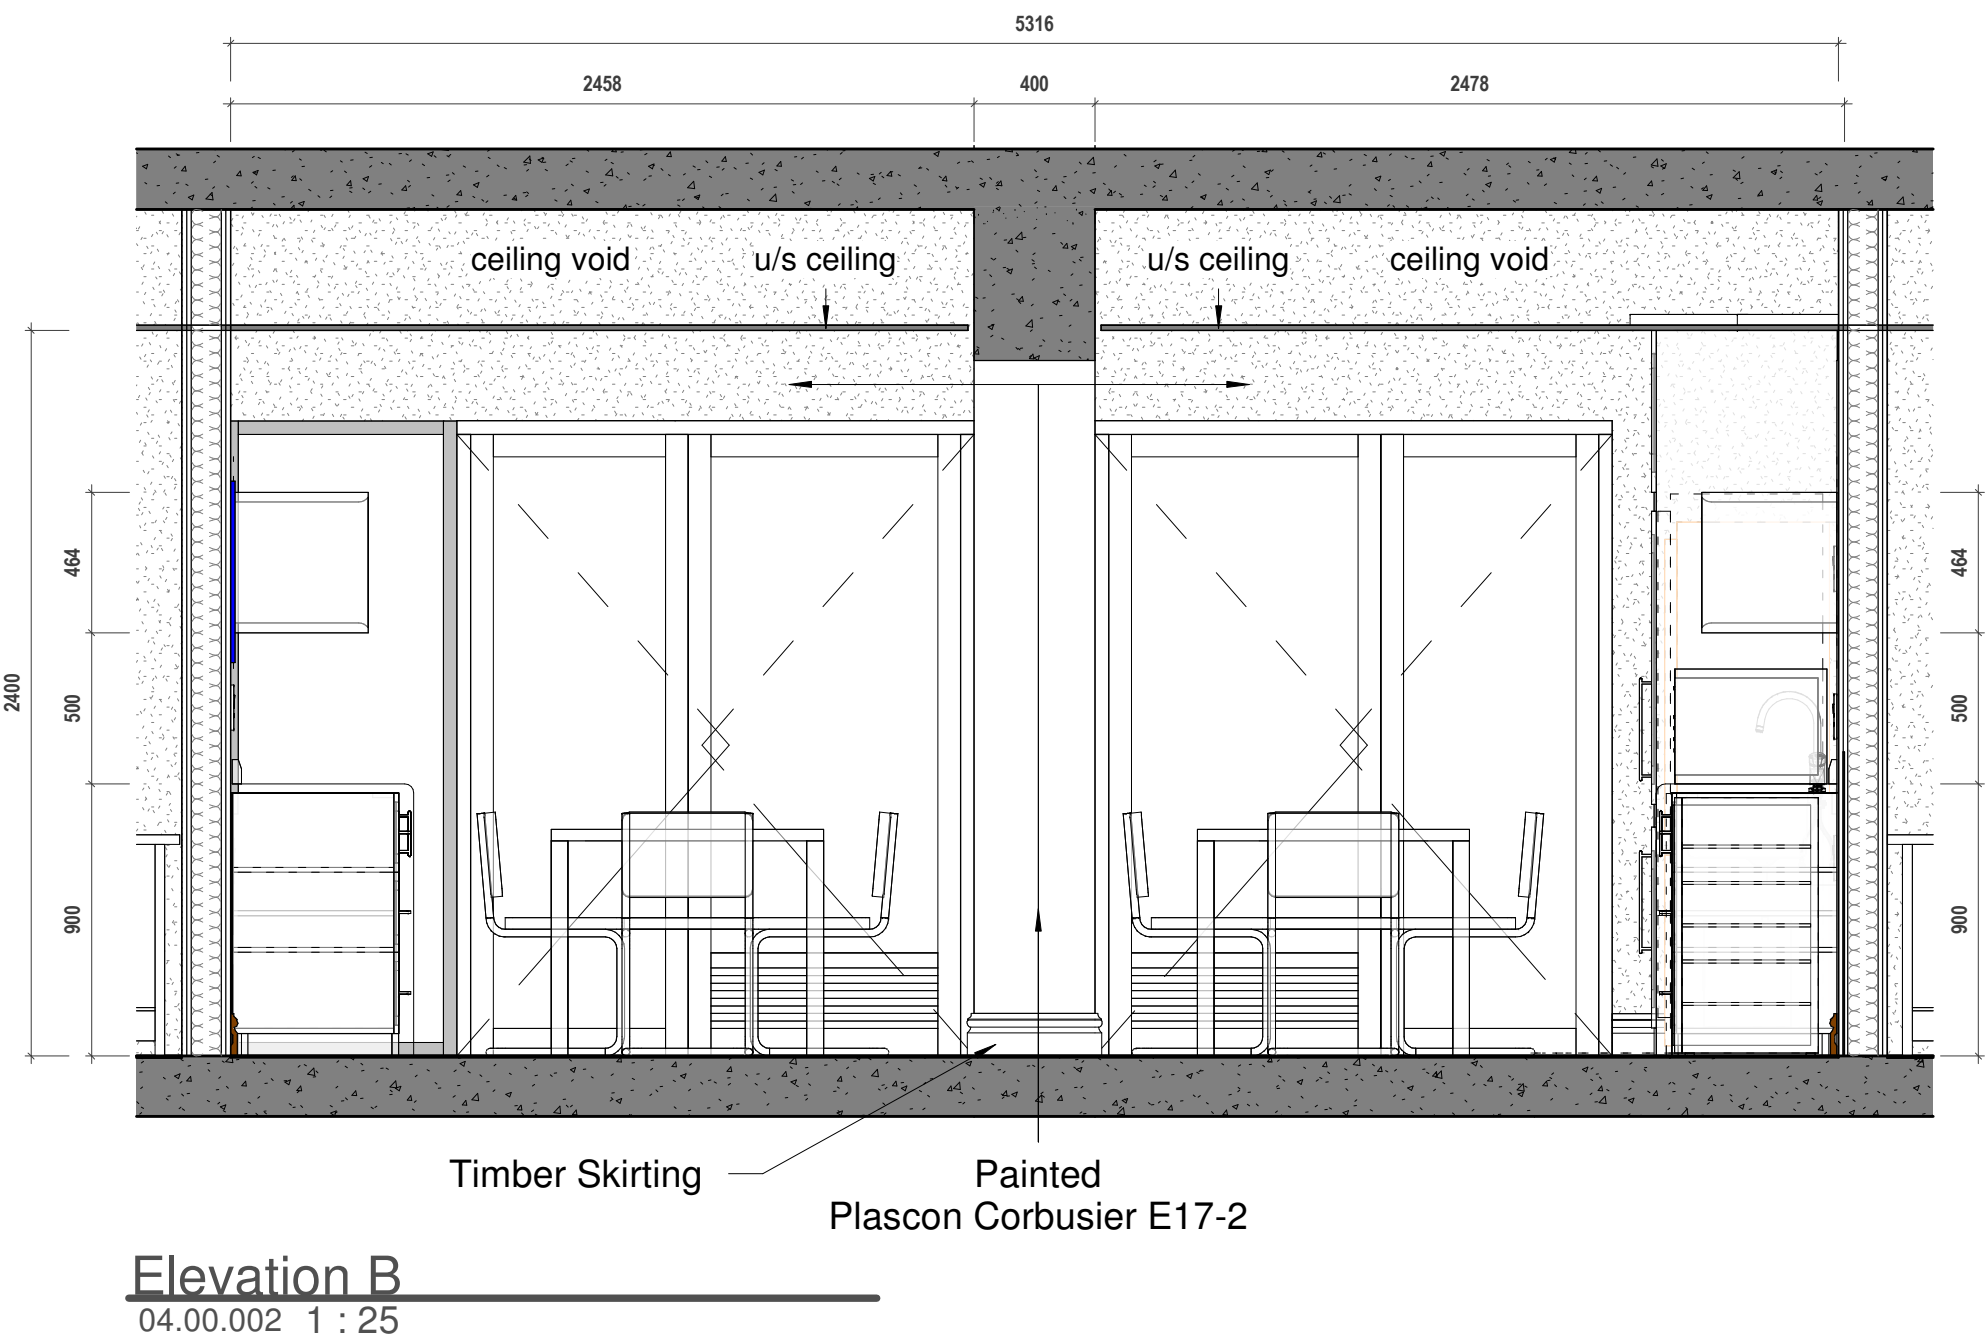


REV	DESCRIPTION	DRAWN	DATE
0	ISSUED FOR CONSTRUCTION		2023.05.30
1	REVISED TREATMENT SPEC. OF EXISTING WINDOW CILL + FASCIA		2023.06.02
2	NOGGING ADDED. TYPICAL OFFICE, Elevation A & Layout		2023.07.21

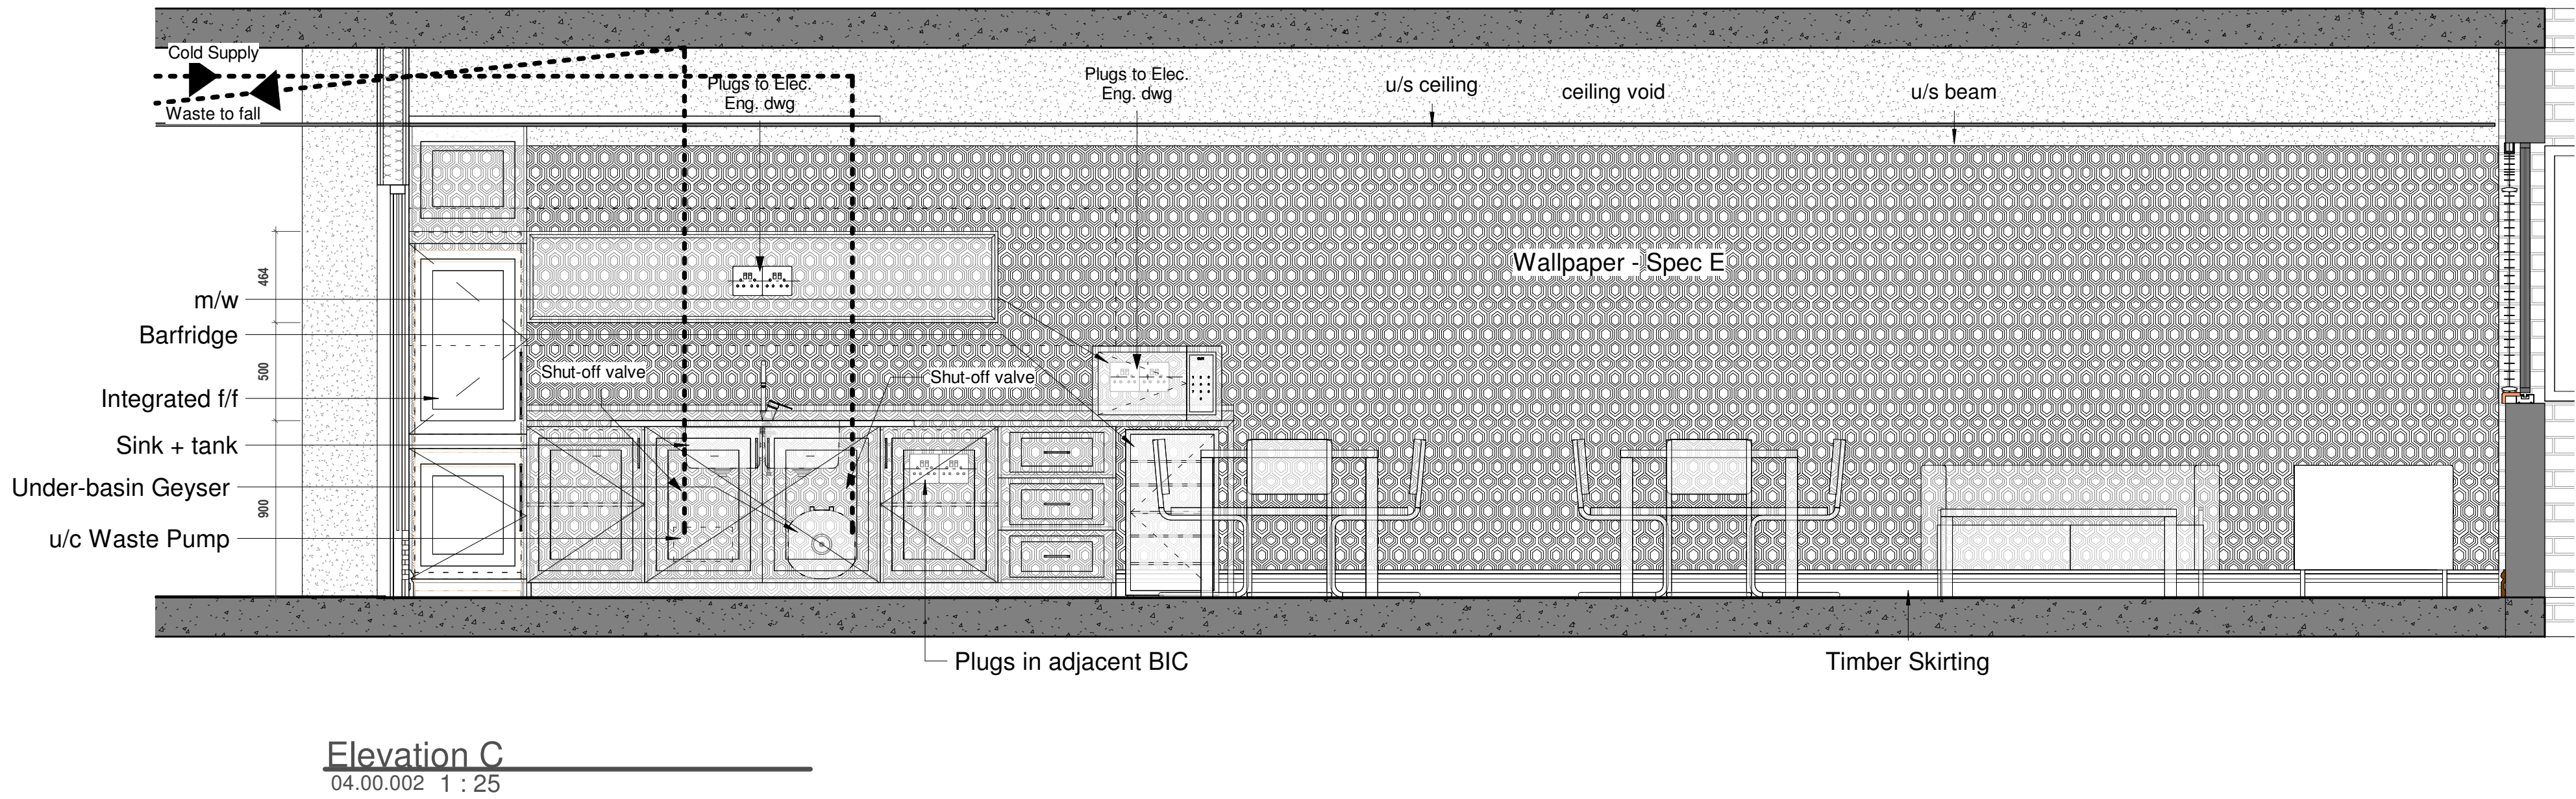

**TREATMENT TO EXISTING
TIMBER CILL + FASCIA**
CLEAN WITH SUGAR-SOAP, LIGHT
SAND WITH 220GRIT, PLASCON
MELAMNE PRIMER, THEN PAINT WITH
VELVAGLO WATER-BASED IN COLOUR:
STONE HARBOUR 10YY48/071

CLIENT:

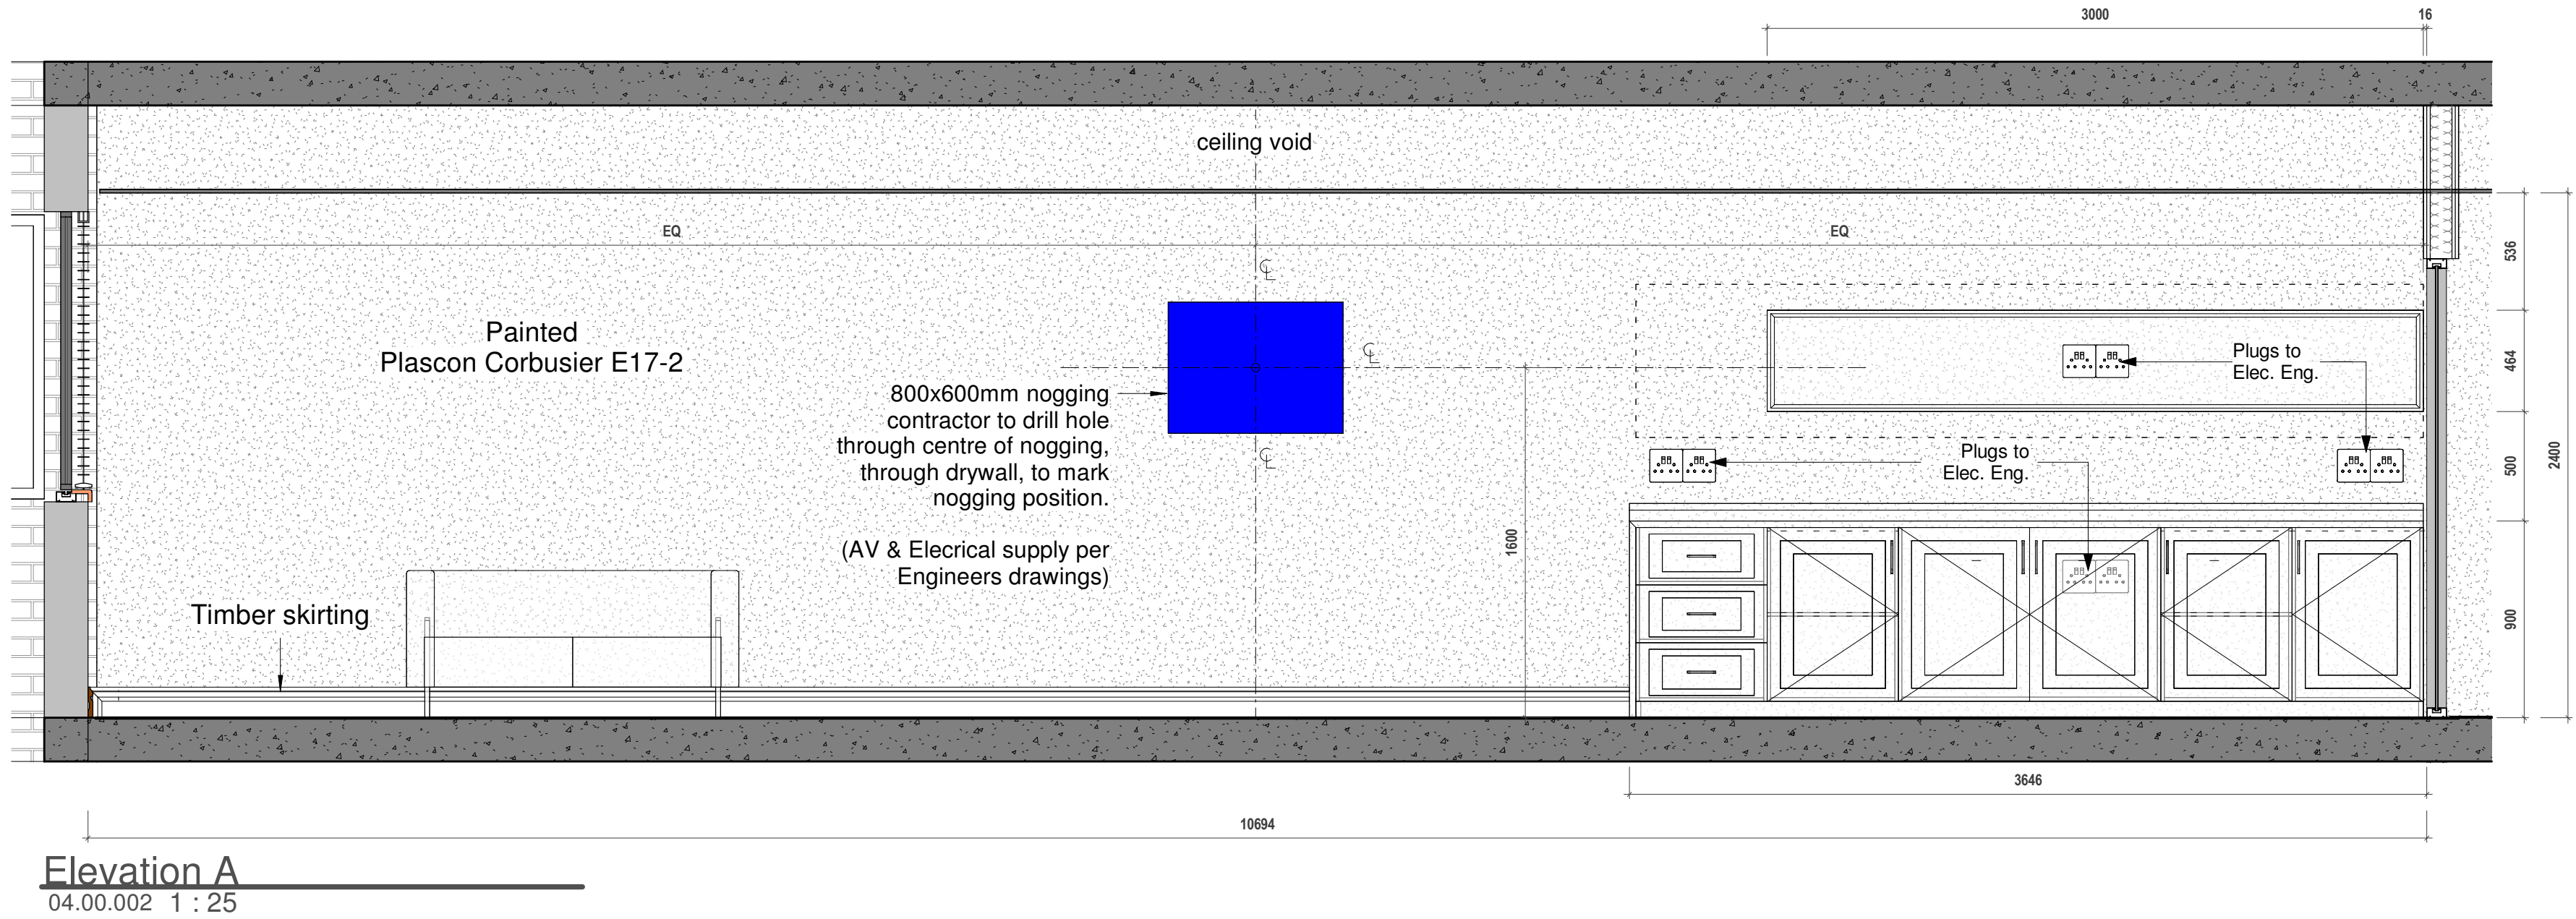

LEAD CONSULTANT:



109_WP A.3 - Temporary Offices For Members
4th & 5th Flr_90 Plein Street

DESIGNED	DRAWN	CHECKED	APPROVED
RP	JVE	RP	RP

TYPICAL KITCHEN ELEVATIONS
DATA SHEET
4th&5th FLOORS

TIME STAMP: 2023/12/12 11:26:46						1 : 25 @ A1	
INFORMATION		LA SUBMISSION		TENDER		CONSTRUCTION	
PROJECT NUMBER		ZONE		STAGE		ISSUE DATE	
109		A00		CON		2023.12.12	
DRAWING NUMBER						REVISION	
109-RRR-A00-XX-DR-04.00.003						2	
PROJECT NO.		ORIG.	ZONE	LEVEL	TYPE	DLS	SHEET NO.

AS-BUILT