


**900x450mm Mirror Detail Elevation**  
1 : 10

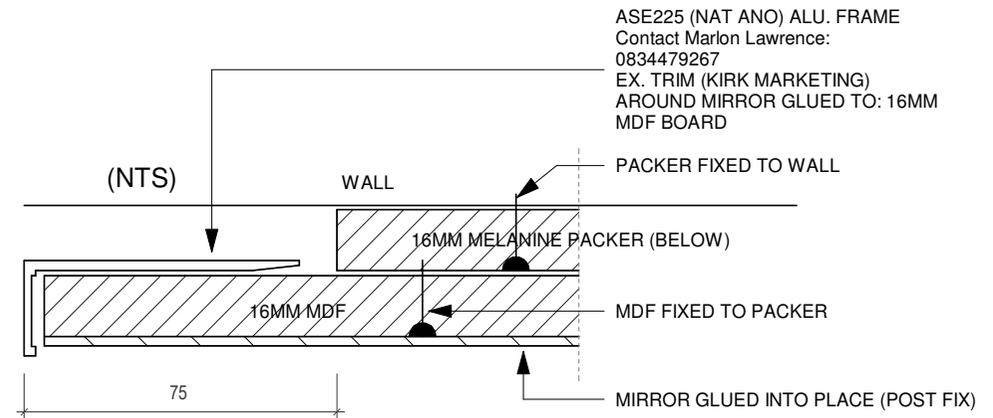

**900x450mm Mirror Detail Plan**  
NTS

**AS-BUILT**

REV	DESCRIPTION	DATE	109_WP A.3 - Temporary Offices For Members	INFORMATION	L.A SUBMISSION	TENDER	CONSTRUCTION
0	ISSUED FOR CONSTRUCTION	2023.08.31		ISSUE DATE: 2023.12.12			SCALE As indicated @ A4
			BATHROOM MIRROR DETAILS 4th&5th FLOORS	DRAWING NUMBER <b>109-RRR-A00-04.00.006a</b>		REVISION <b>0</b>	
				PROJECT NO.	ORIG.	ZONE	LEVEL   TYPE   DIS.   SHEET NO.