


PLEIN STREET

FOR GENERAL NOTES REFER TO DRAWING NUMBER: 2020_R000-RRA-A00-XX-NB-A-10.00.000

REV	DESCRIPTION	DRAWN	DATE
0	ISSUED FOR CONSTRUCTION		2023.05.30
1	ENABLING WORKS @ 1st FLOOR LAYOUTS - SIGN LANGUAGE INTERPRETOR 1&2 OMITTED FROM SCOPE OF WORKS		2023.07.04
2	ENABLING WORKS @ 1st FLOOR LAYOUTS - HOUSEHOLD SERVICES ROOMS-NEW OFFICE OMITTED FROM SCOPE OF WORKS		2023.07.20

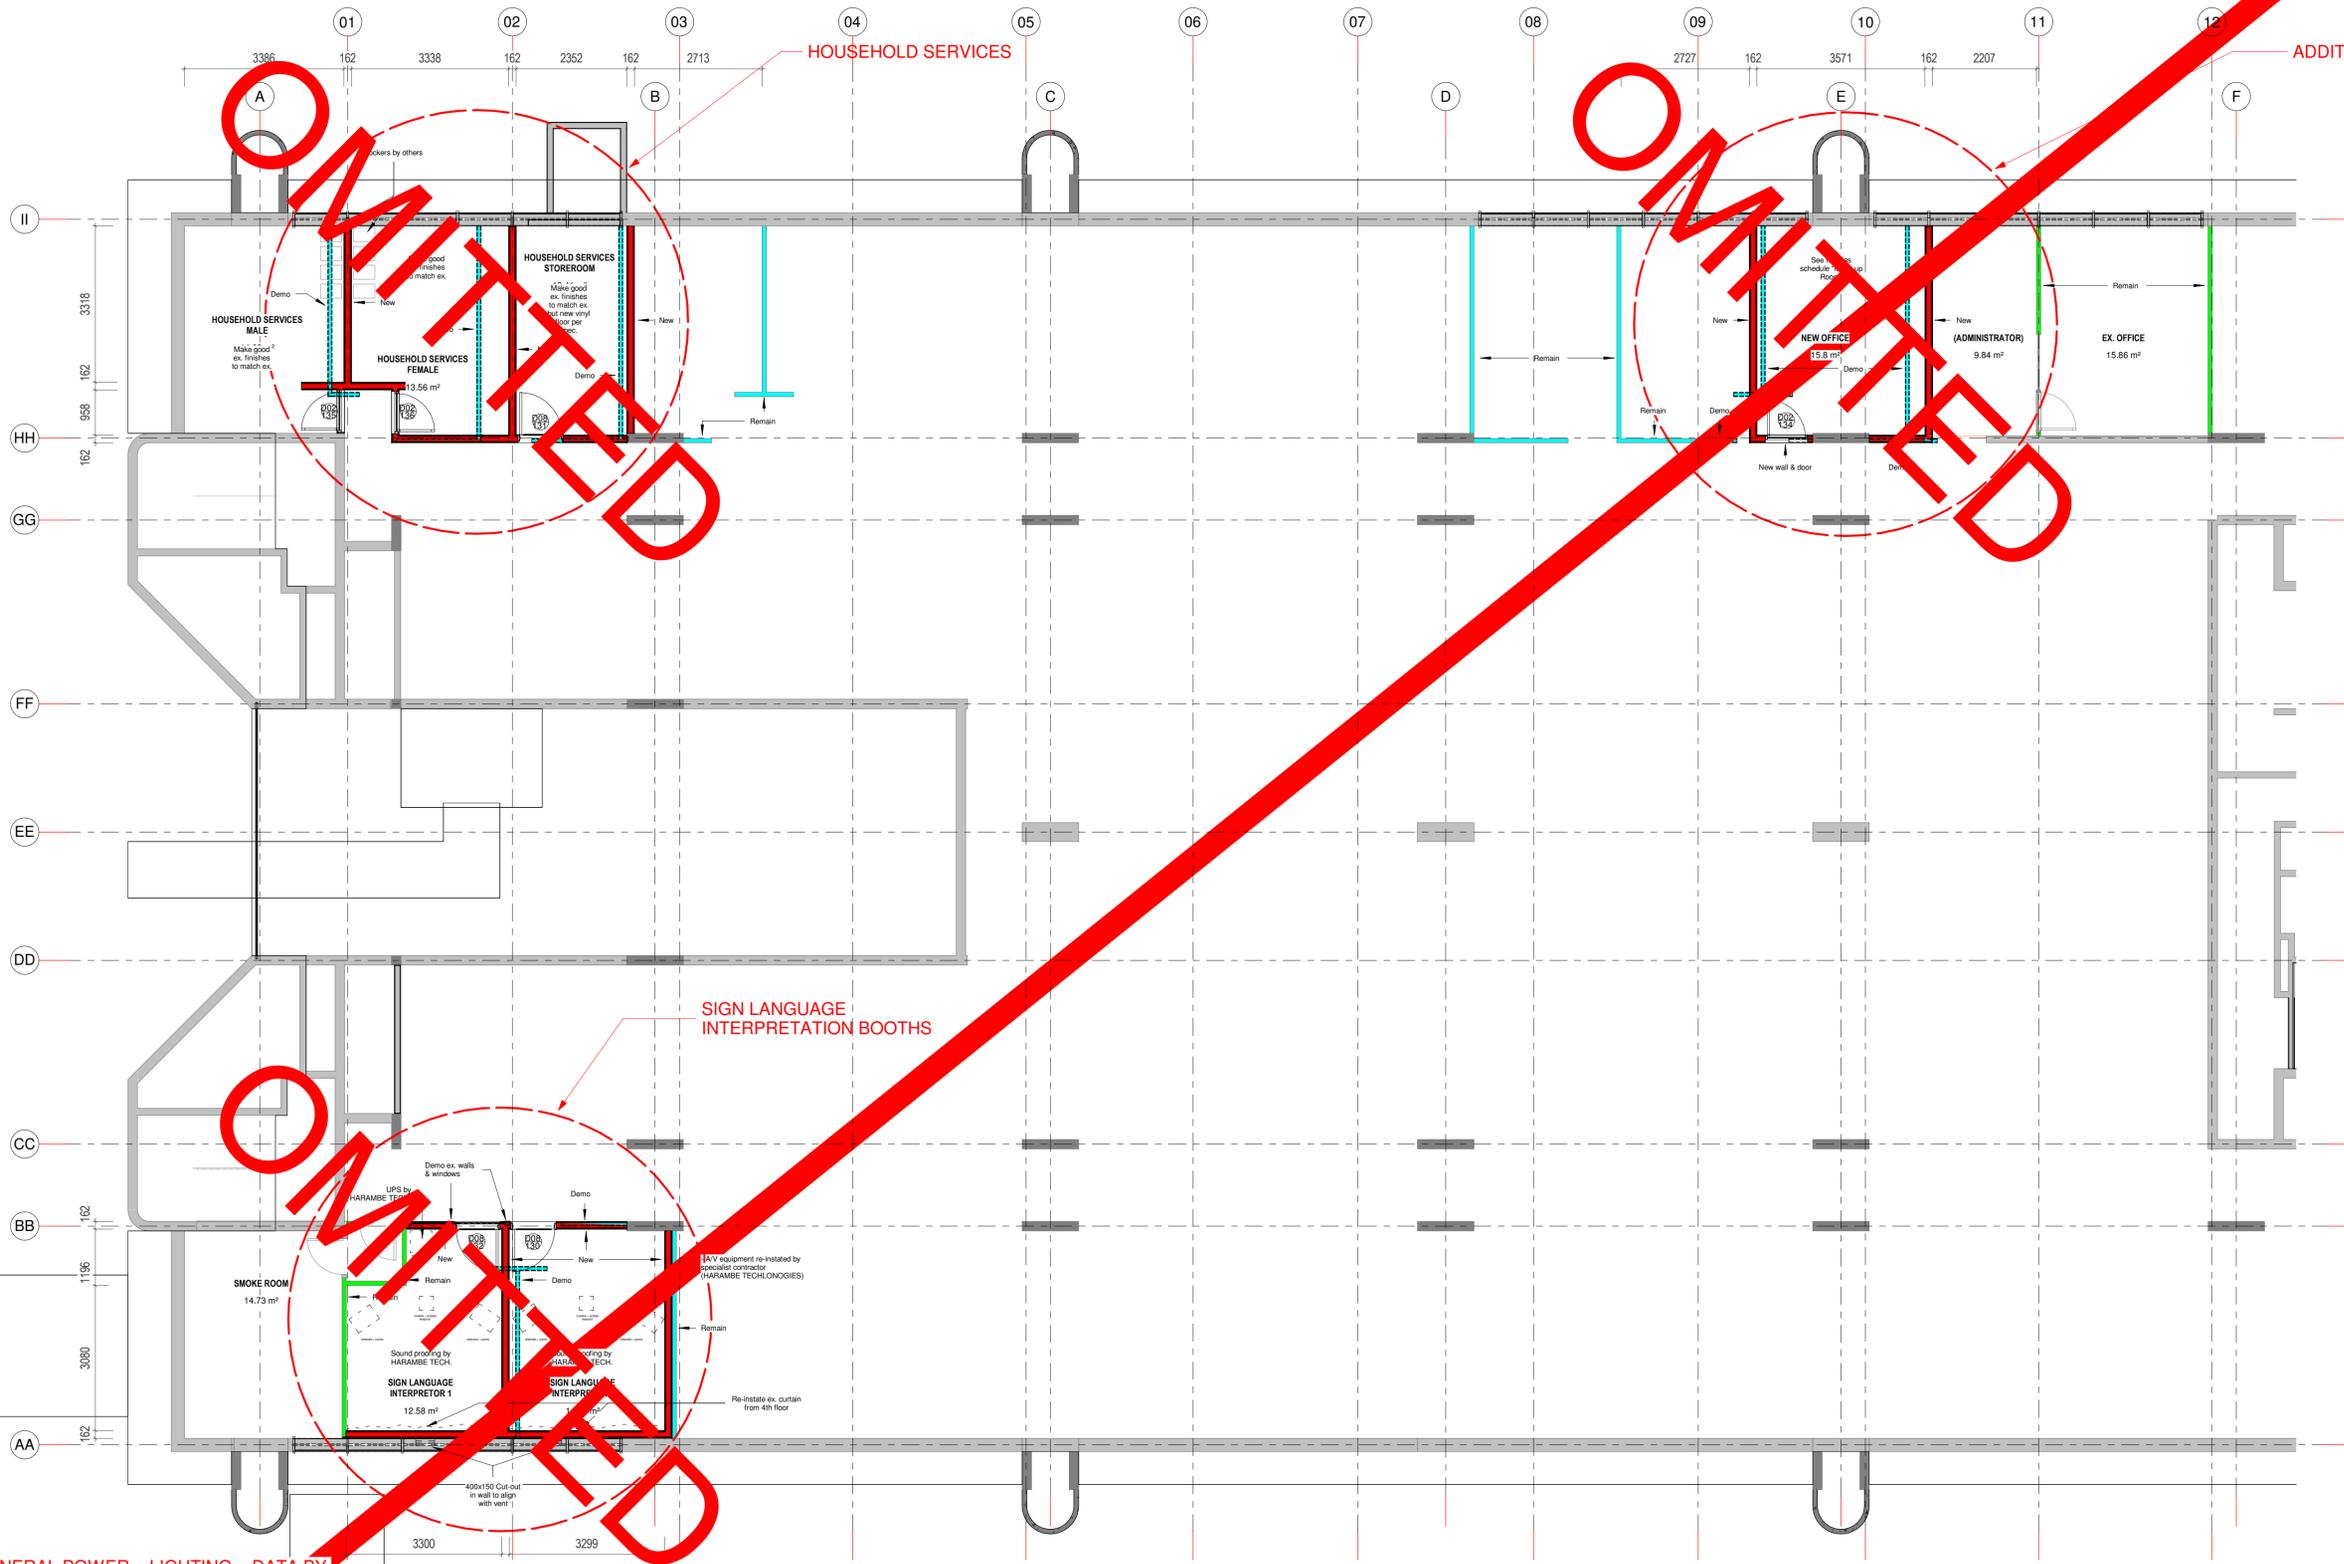

- GENERAL POWER + LIGHTING + DATA BY ELEC. ENG.
 - UPS, SPOTLIGHTS, SPEAKERS, FIBRE OPTIC, OTHER AV EQUIPMENT BY HARAMBE TECH.

GA-PROPOSED FIRST STOREY LAYOUT
 01.00.002 1 : 75

WALLS LEGEND

	New 150mm GYPROC FIRE RESISTANT WALL SYSTEM, OR SIMILAR APPROVED (150mm and 500L)
	EXISTING WALLS + CONCRETE COLUMNS
	EXISTING HALF HEIGHT DRYWALL + 300mm GLAZING INSERT
	EXISTING FULL HEIGHT DRYWALL + GLAZING & DOORS
	EXISTING HALF HEIGHT DRYWALL + 300mm GLAZING INSERT TO BE DEMOLISHED
	EXISTING FULL HEIGHT DRYWALL + GLAZING & DOORS TO BE DEMOLISHED (EXCLUDING DATA SWITCH ROOM)

AS-BUILT

CLIENT:

Building Africa's Prosperity

LEAD CONSULTANT:

ruben reddy architects

Durban | Johannesburg | Cape Town | Bloemfontein | Polokwane
 info@rubenreddyarch.co.za | www.rubenreddyarch.co.za

109_WP A.3 - Temporary Offices For Members
 4th & 5th Fir_90 Plein Street

DESIGNED	DRAWN	CHECKED	APPROVED
RP	JVE	RP	RP

ENABLING WORKS
 1st FLOOR LAYOUTS

INFORMATION	LA SUBMISSION	TENDER	CONSTRUCTION
PROJECT NUMBER	ZONE	STAGE	ISSUE DATE
109	A00	CON	2023-12-12
DRAWING NUMBER			REVISION
109-RRA-A00-00-DR-00.01.000			2