



ISO A1 840mm x 594mm


LIFT LOBBY ABLUTIONS

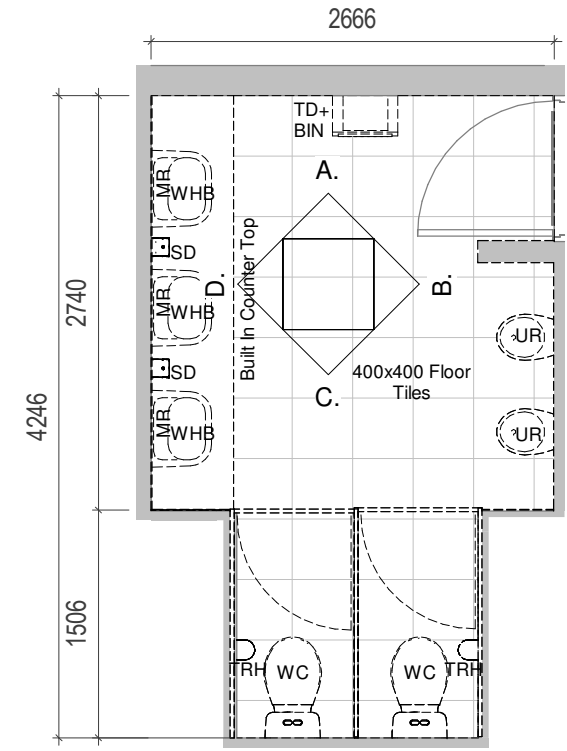

x1 MALE @EACH 4th+5th FLOORS
1 : 50

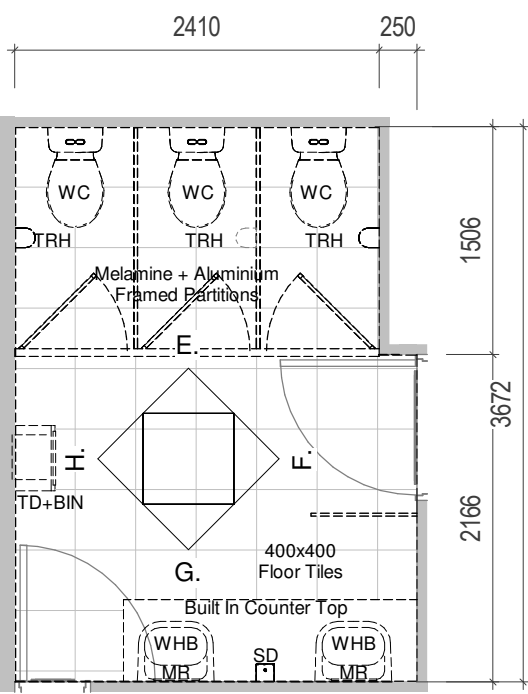


x1 FEMALE @EACH 4th+5th FLOORS
1 : 50

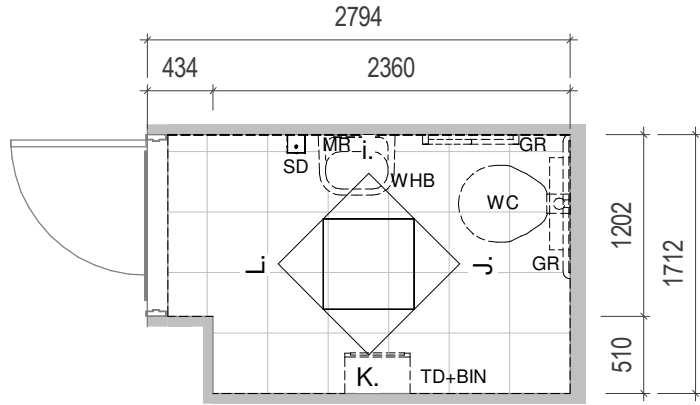


x1 DISABLED @EACH 4th+5th FLOORS
1 : 50

@HALF LANDING BETWEEN 4th+5th FLOORS

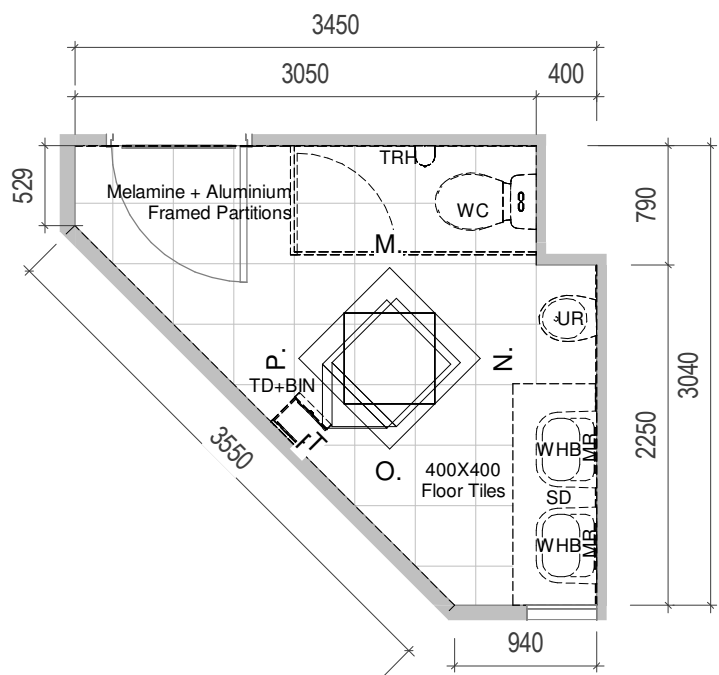

x4 MALE_BTWN 4th+5th FLOORS
1 : 50

@HALF LANDING BETWEEN 5th+6th FLOORS

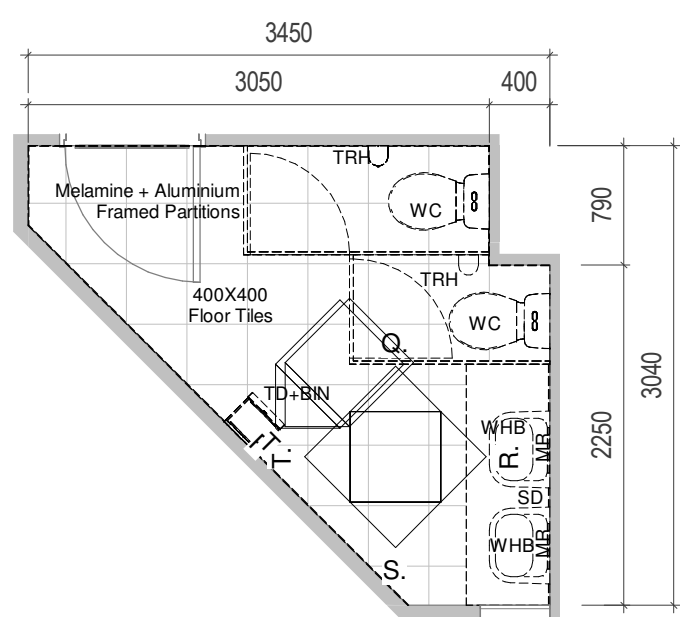


x2 FEMALE_BTWN 5th+6th FLOORS
1 : 50

SANITARYWARE LEGEND


- WC = Toilet
WHB = Wash Hand Basins
SD = Soap Dispenser
TD = Towel Dispenser
GR = Grab Rail
MR = Mirror
TRH = Toilet Roll Holder
BIN = Waste Bin

Cubicle Partitions
• Vitrex, Vitraflex "Classic"
Modular Toilet Cubicles, or
Similar Approved


Floor Finish = Vinyl Tiles
Wall Finish = Wall Tiles+
Wall Paper_Type C

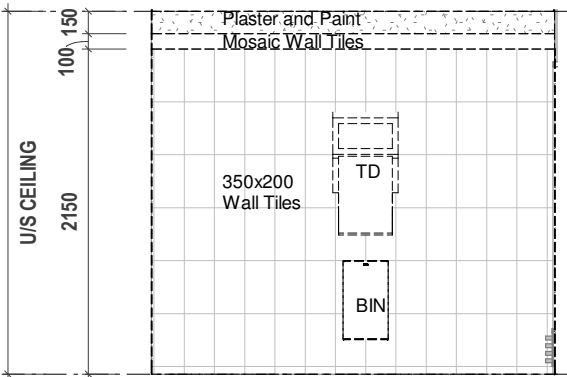


ELEVATION A
1 : 50

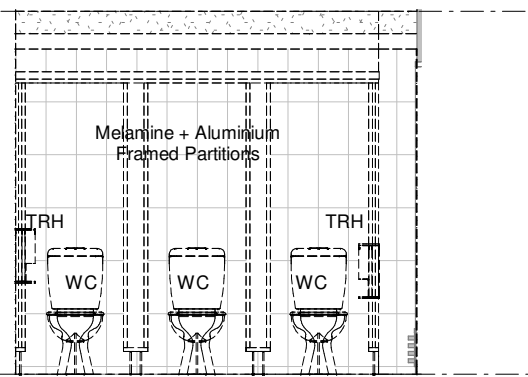


ELEVATION E
1 : 50

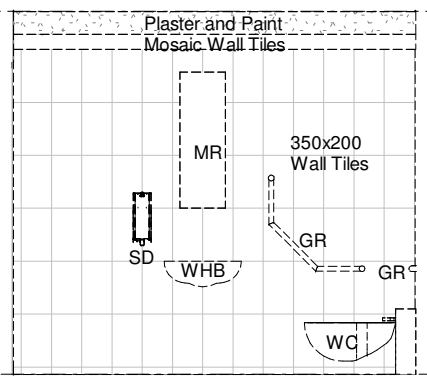


ELEVATION I
1 : 50

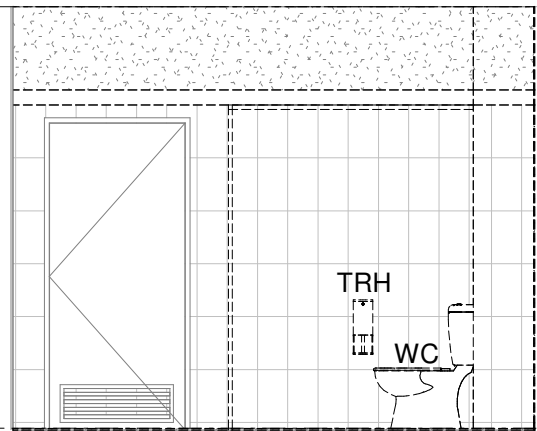


ELEVATION M
1 : 50

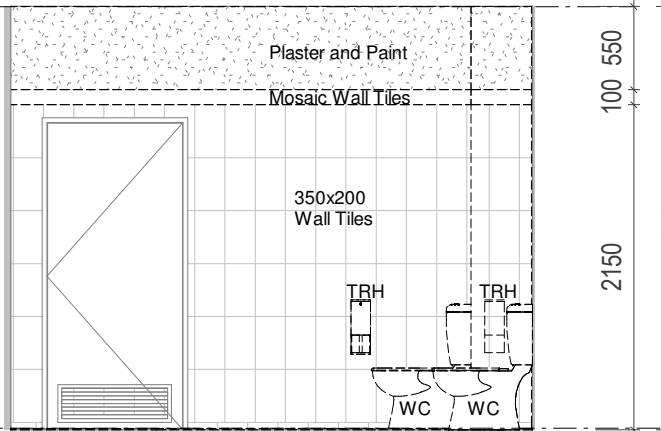


ELEVATION Q
1 : 50

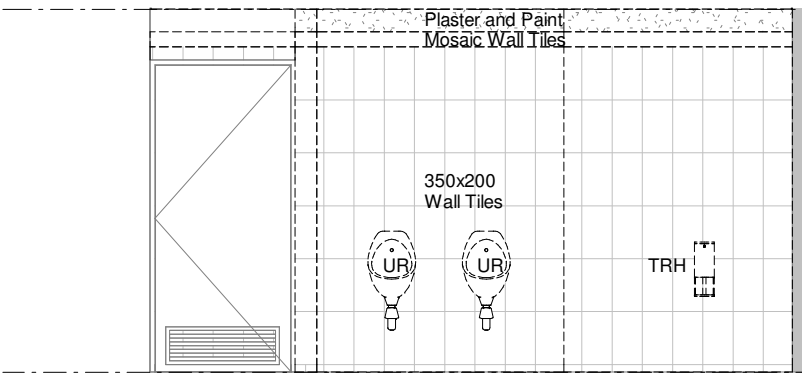


ELEVATION B
1 : 50

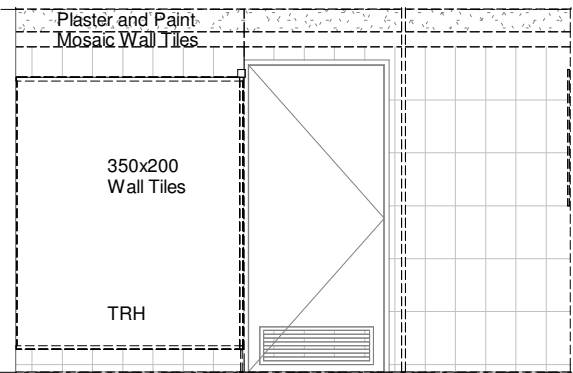


ELEVATION F
1 : 50

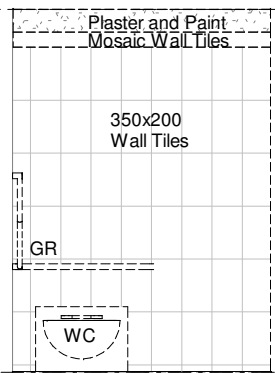


ELEVATION J
1 : 50

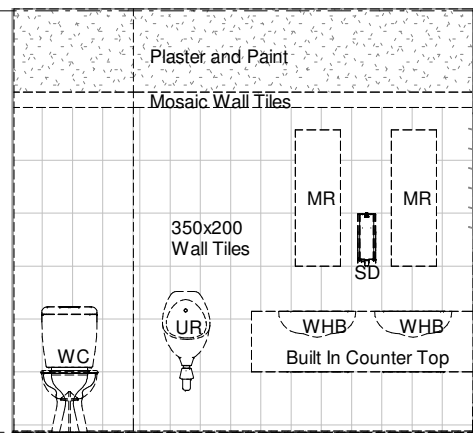


ELEVATION N
1 : 50

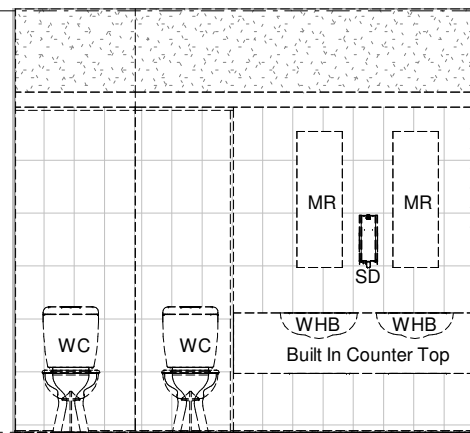


ELEVATION R
1 : 50

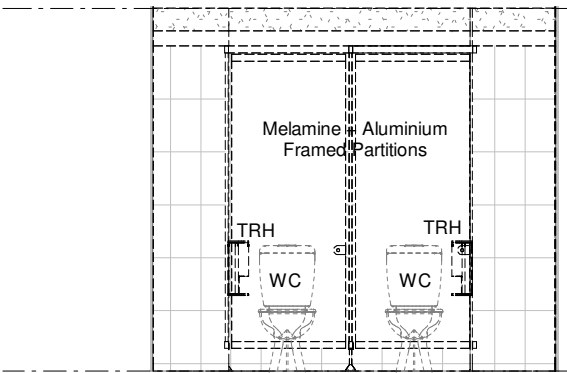


ELEVATION C
1 : 50

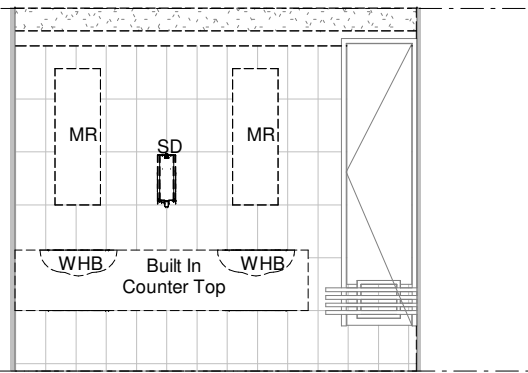


ELEVATION G
1 : 50

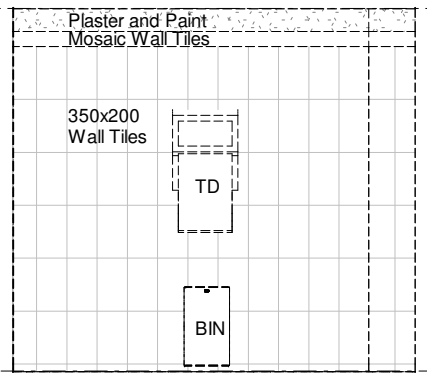


ELEVATION K
1 : 50

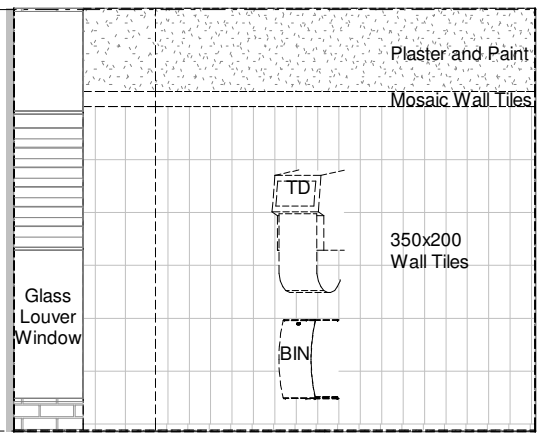


ELEVATION O
1 : 50

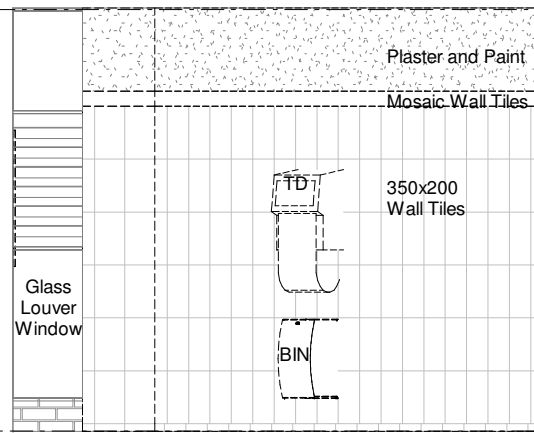


ELEVATION S
1 : 50

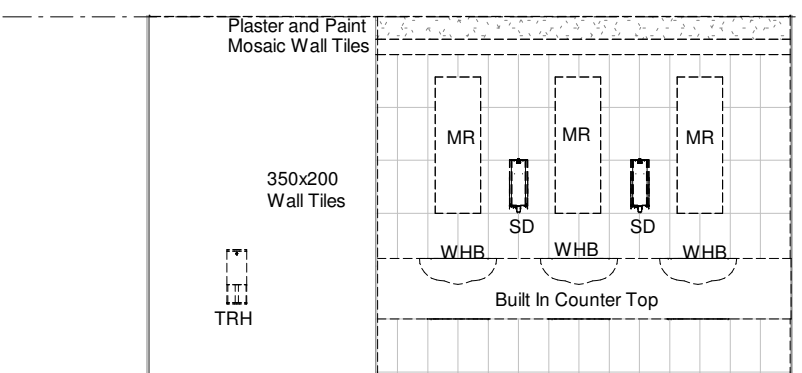


ELEVATION D
1 : 50

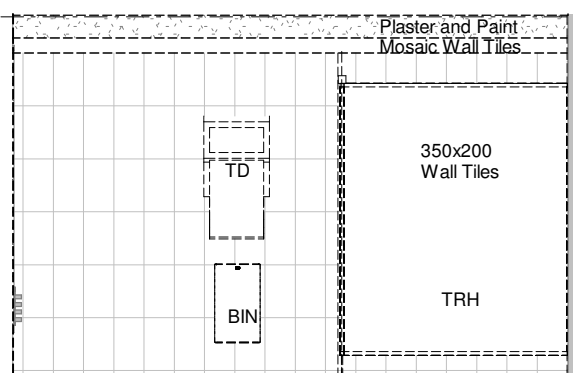


ELEVATION H
1 : 50

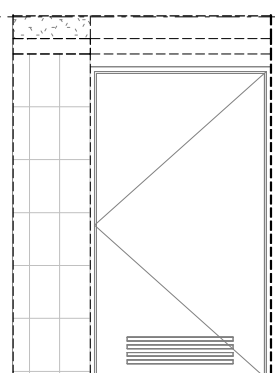

ELEVATION L
1 : 50

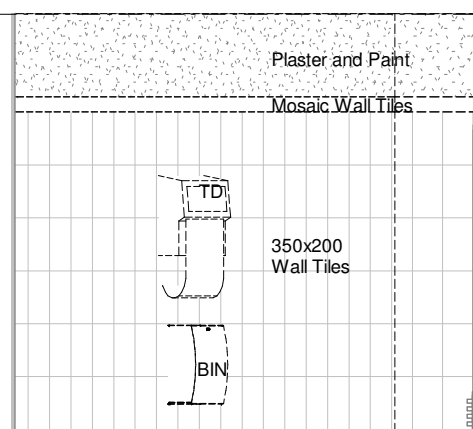

ELEVATION P
1 : 50

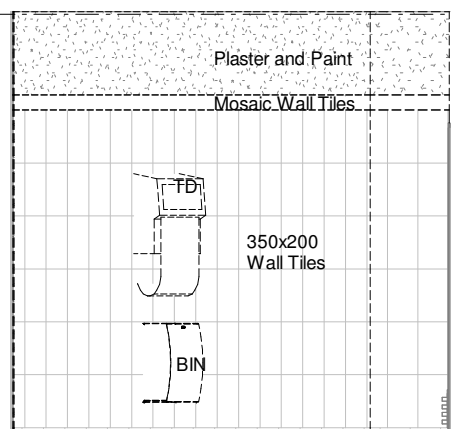

ELEVATION T
1 : 50

CLIENT:



Building Africa's Prosperity

LEAD CONSULTANT:



ruben reddy architects
Durban | Johannesburg | Cape Town | Bloemfontein | Polokwane
info@rubenreddyarch.co.za | www.rubenreddyarch.co.za

109_WP A.3 - Temporary Offices For
Members
4th & 5th Flr_90 Plein Street

DESIGNED	DRAWN	CHECKED	APPROVED
RP	JN	RP	RP

ABLUTIONS DEMOLITION WORKS
4th & 5th FLOORS

TIME STAMP: 2023/12/19 12:35:05		As indicated @ A1	
INFORMATION	LA SUBMISSION	TENDER	CONSTRUCTION
PROJECT NUMBER	ZONE	STAGE	ISSUE DATE
109	A00	CON	2023-12-12
DRAWING NUMBER			REVISION
109-RRR-A00-00-DR-00.02.001			0
PROJECT NO.	ORIG.	ZONE	LEVEL
109-RRR-A00-00-DR-00.02.001	1	A00	02

AS-BUILT