



JOINERY 3&4 _ FLOOR PLAN
1:20




3D JOINERY 3&4

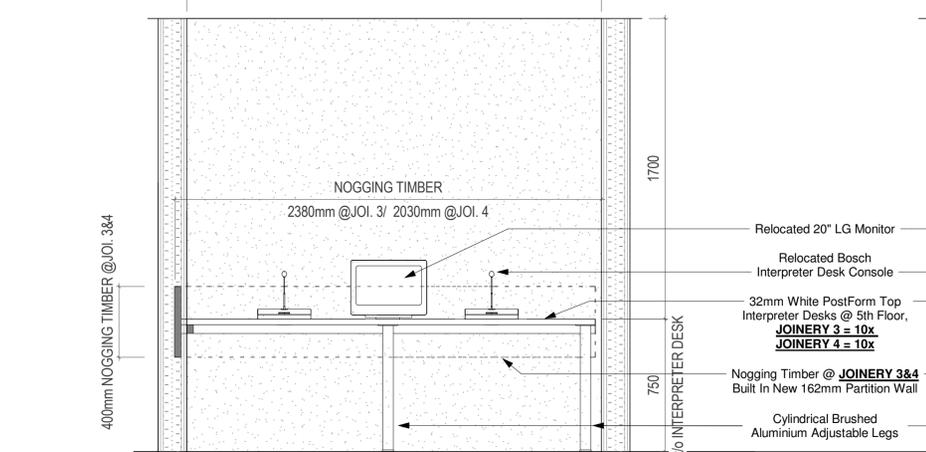


JOINERY 3&4 _ FRONT ELEVATION
1:20

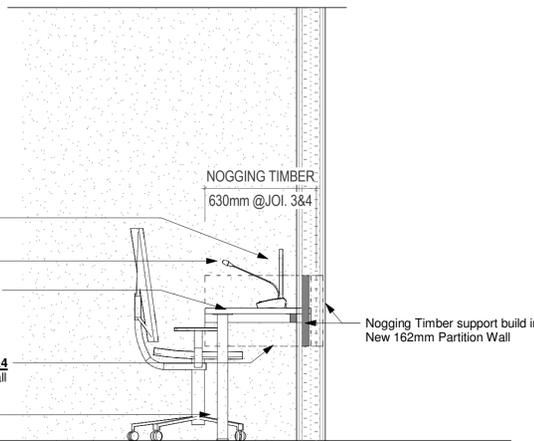

JOINERY 3&4 _ SIDE ELEVATION
1:20

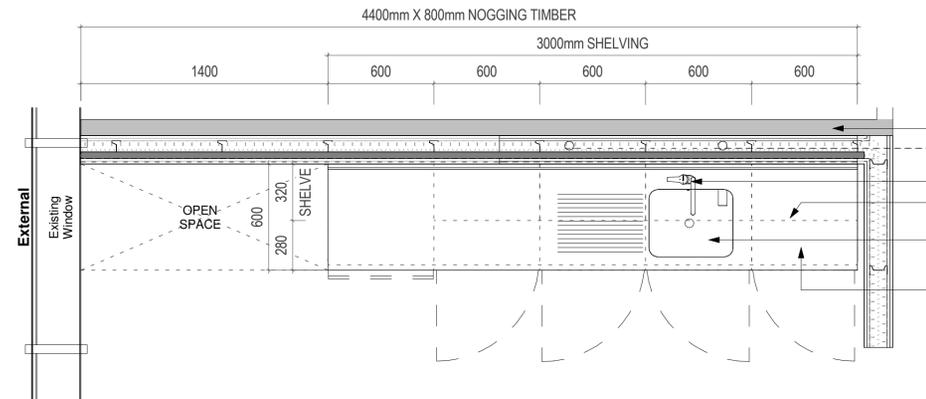


JOINERY 05 - HOT DESK KITCHEN_ 5TH FLOOR
1:20

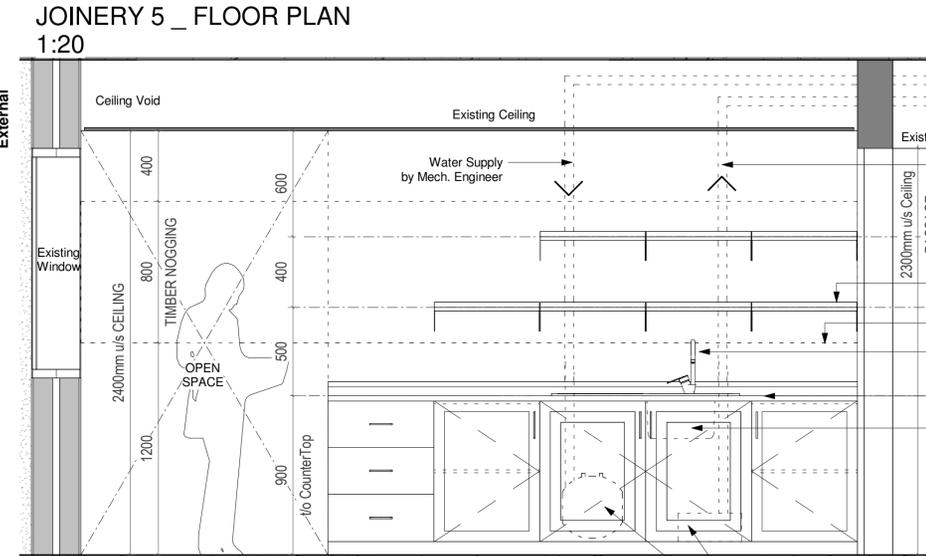


JOINERY 5 _ FLOOR PLAN
1:20



JOINERY 5 _ FRONT ELEVATION
1:20

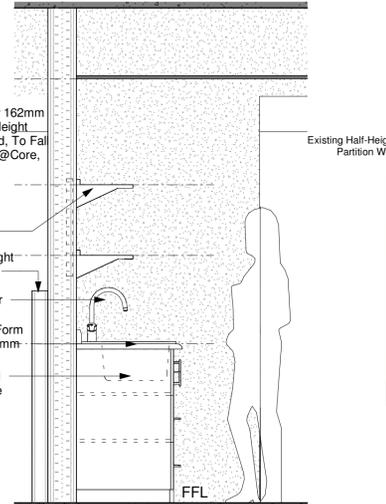

JOINERY 5 _ FRONT ELEVATION
1:20

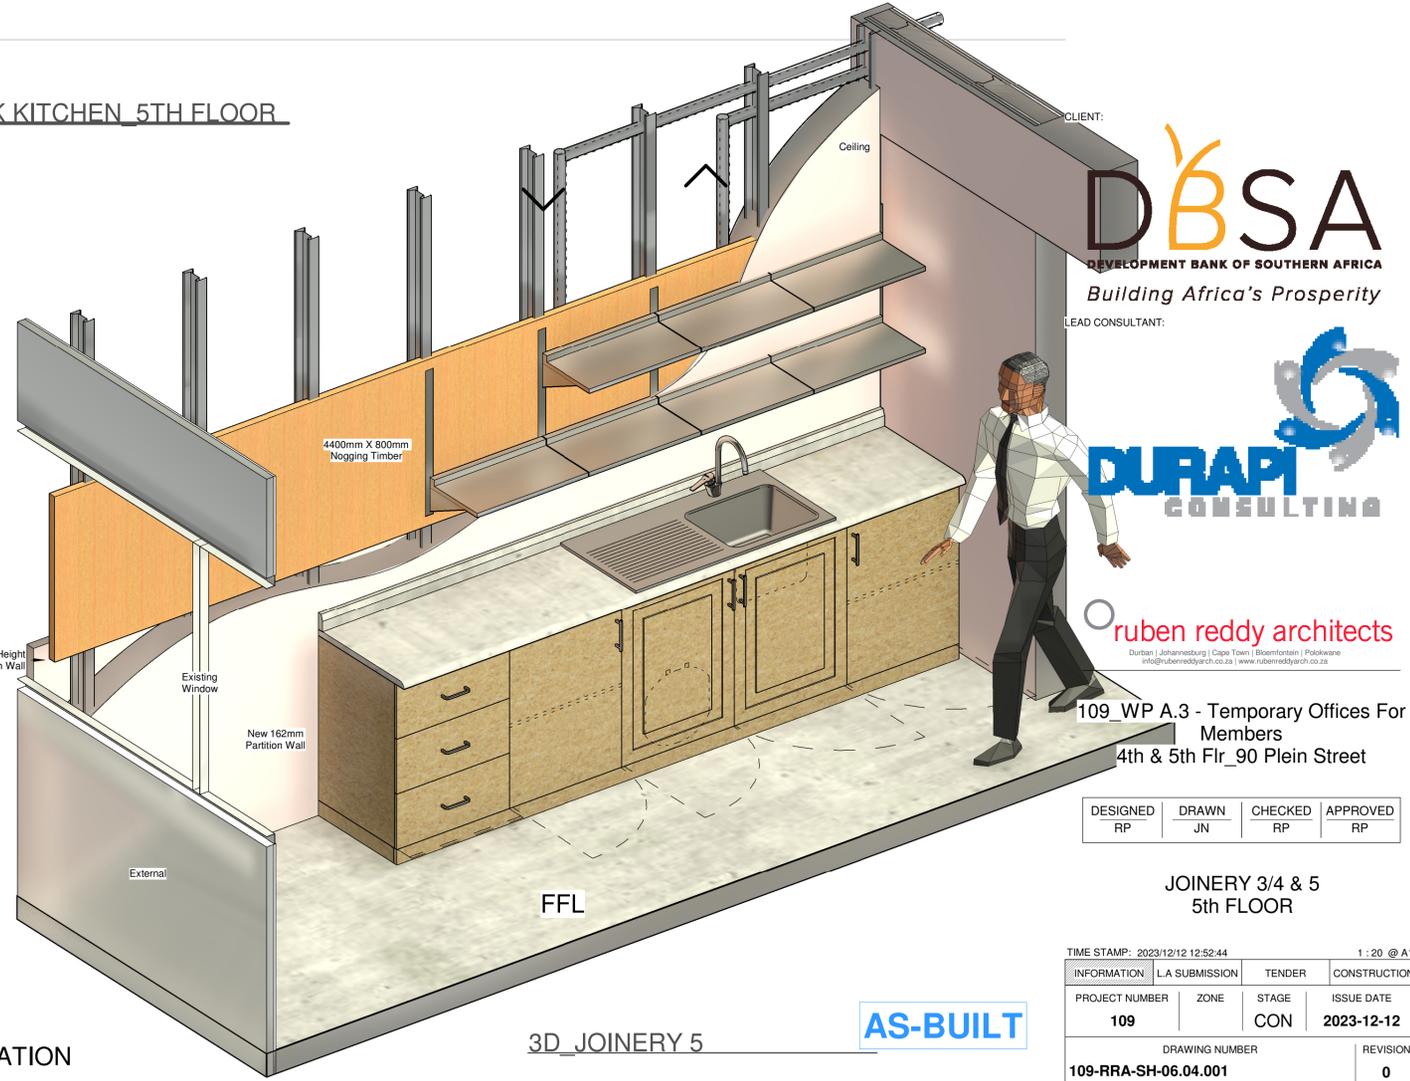

3D JOINERY 5

CLIENT:
DBSA
 DEVELOPMENT BANK OF SOUTHERN AFRICA
Building Africa's Prosperity
 LEAD CONSULTANT:
DURAPI
 CONSULTING

ruben reddy architects
 Durban | Johannesburg | Cape Town | Bloemfontein | Polokwane
 info@rubenreddyarch.co.za | www.rubenreddyarch.co.za

109_WP A.3 - Temporary Offices For Members
 4th & 5th Flr_90 Plein Street

DESIGNED RP	DRAWN JN	CHECKED RP	APPROVED RP
----------------	-------------	---------------	----------------

JOINERY 3/4 & 5
5th FLOOR

TIME STAMP: 2023/12/12 12:52:44	1:20 @ A1		
INFORMATION	LA SUBMISSION	TENDER	CONSTRUCTION
PROJECT NUMBER 109	ZONE	STAGE CON	ISSUE DATE 2023-12-12
DRAWING NUMBER 109-RRR-SH-06.04.001			REVISION 0
PROJECT NO.	ORIG.	ZONE	LEVEL

AS-BUILT