



ISO A1 840mm x 594mm

• FOR GENERAL NOTES REFER TO DRAWING NUMBER : 2020_R000-RRA-A00-XX-NB-A-10.00.000


REV	DESCRIPTION	DRAWN	DATE
0	ISSUED FOR CONSTRUCTION		2023.05.30
1	NEW BULKHEAD CEILING DETAIL		2023.08.01

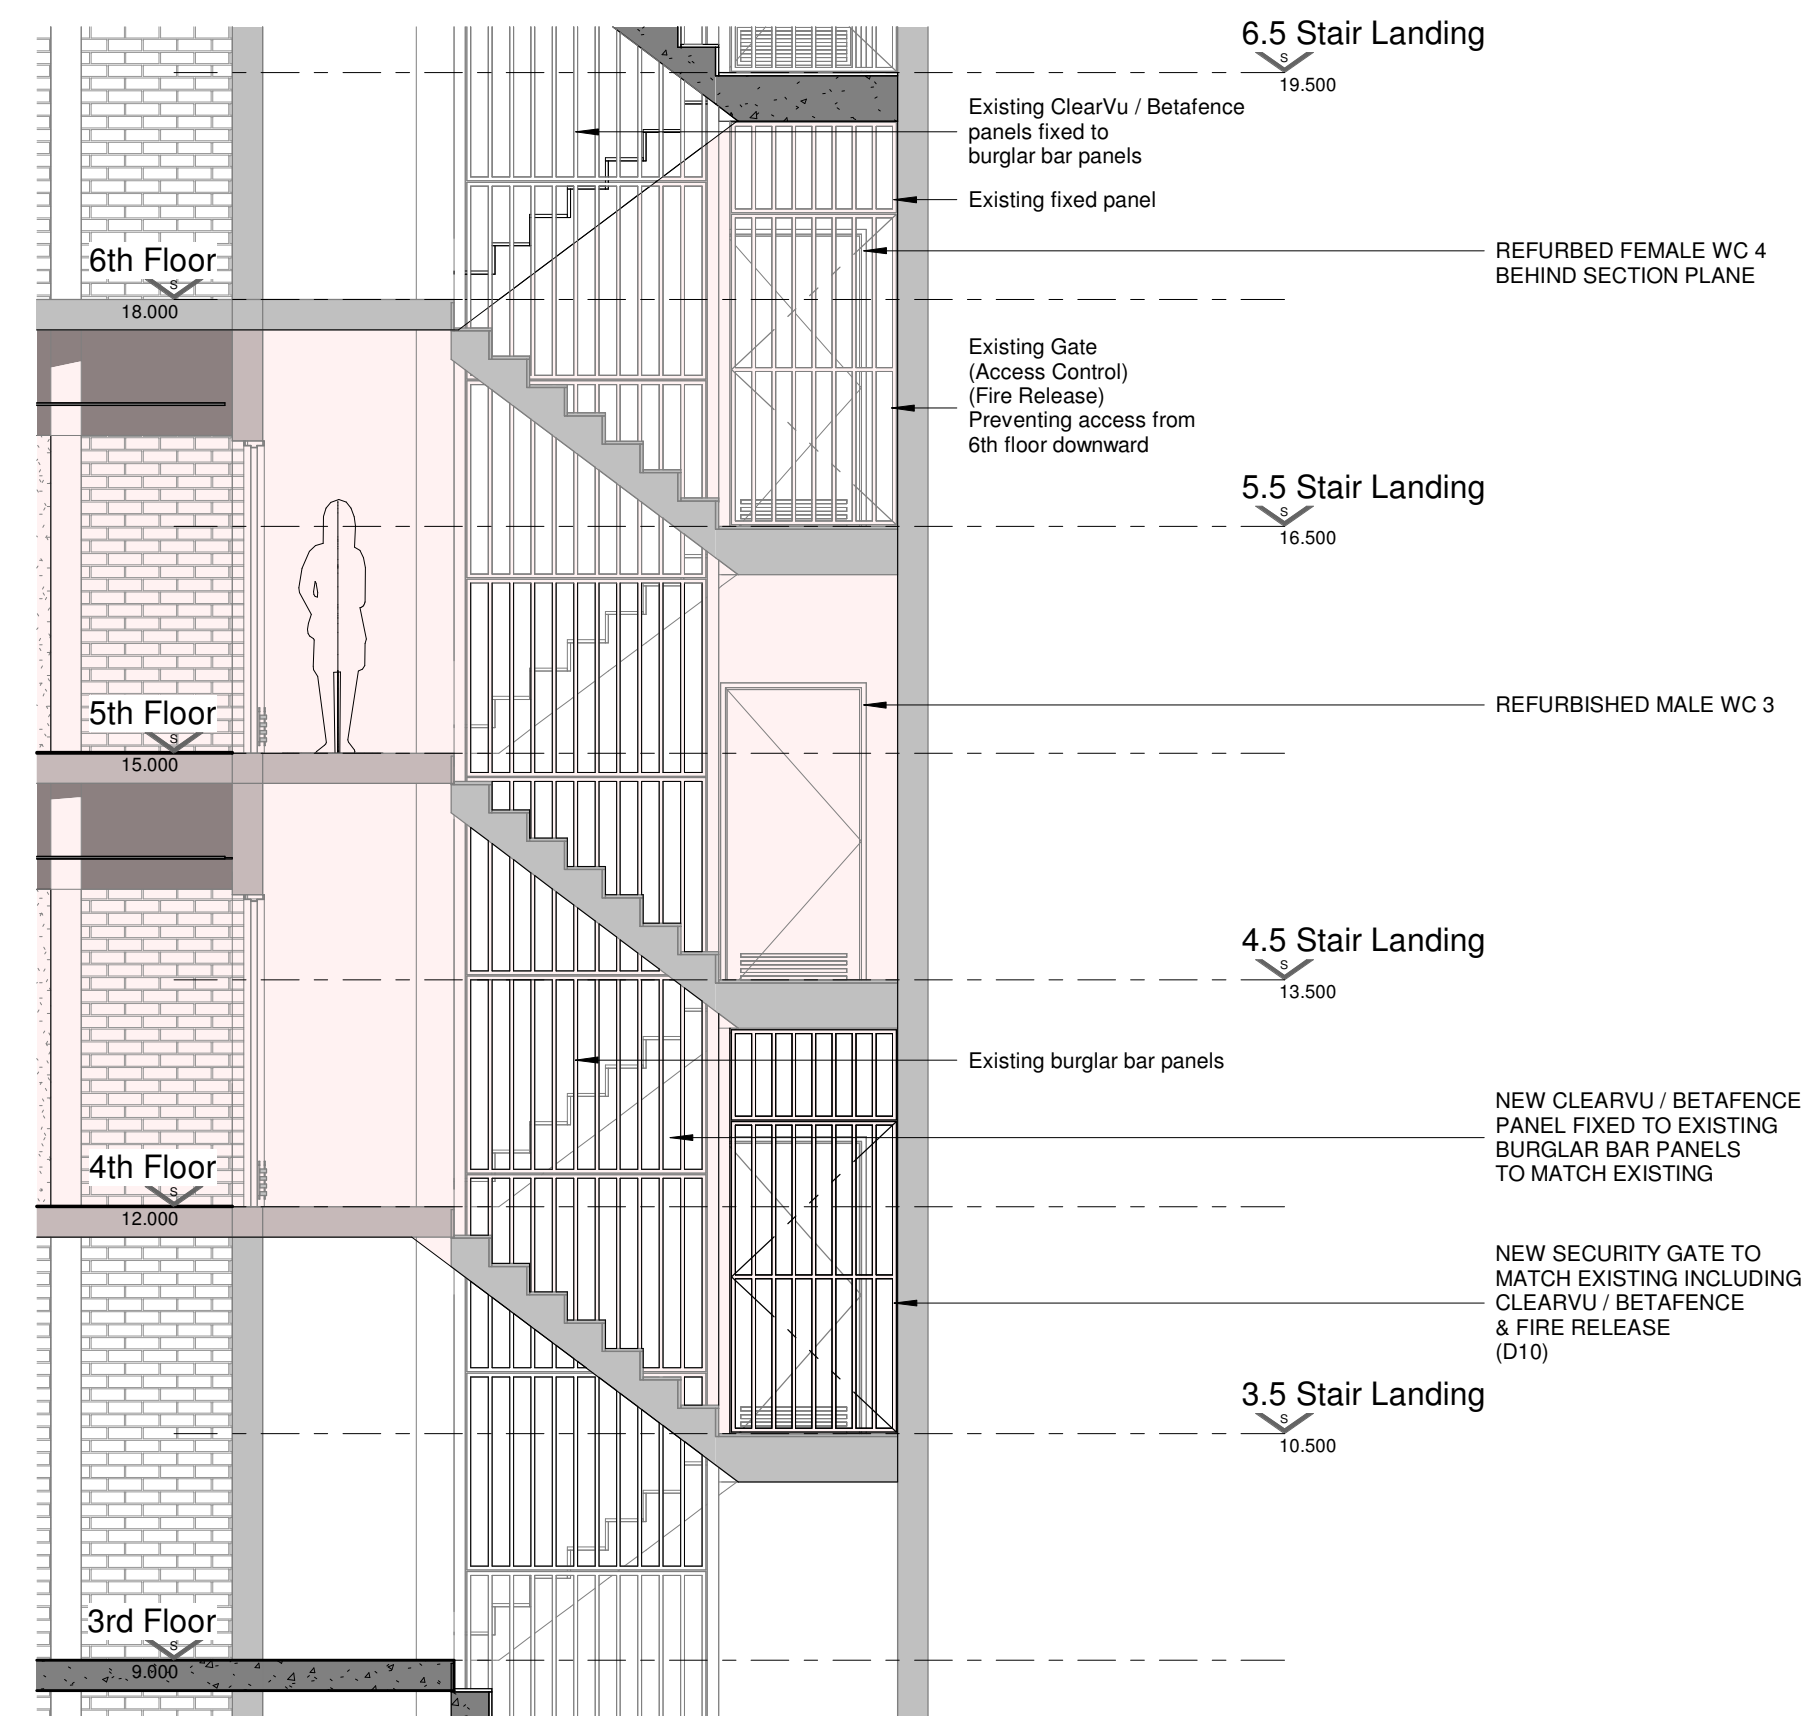


SECTION 2
1 : 50

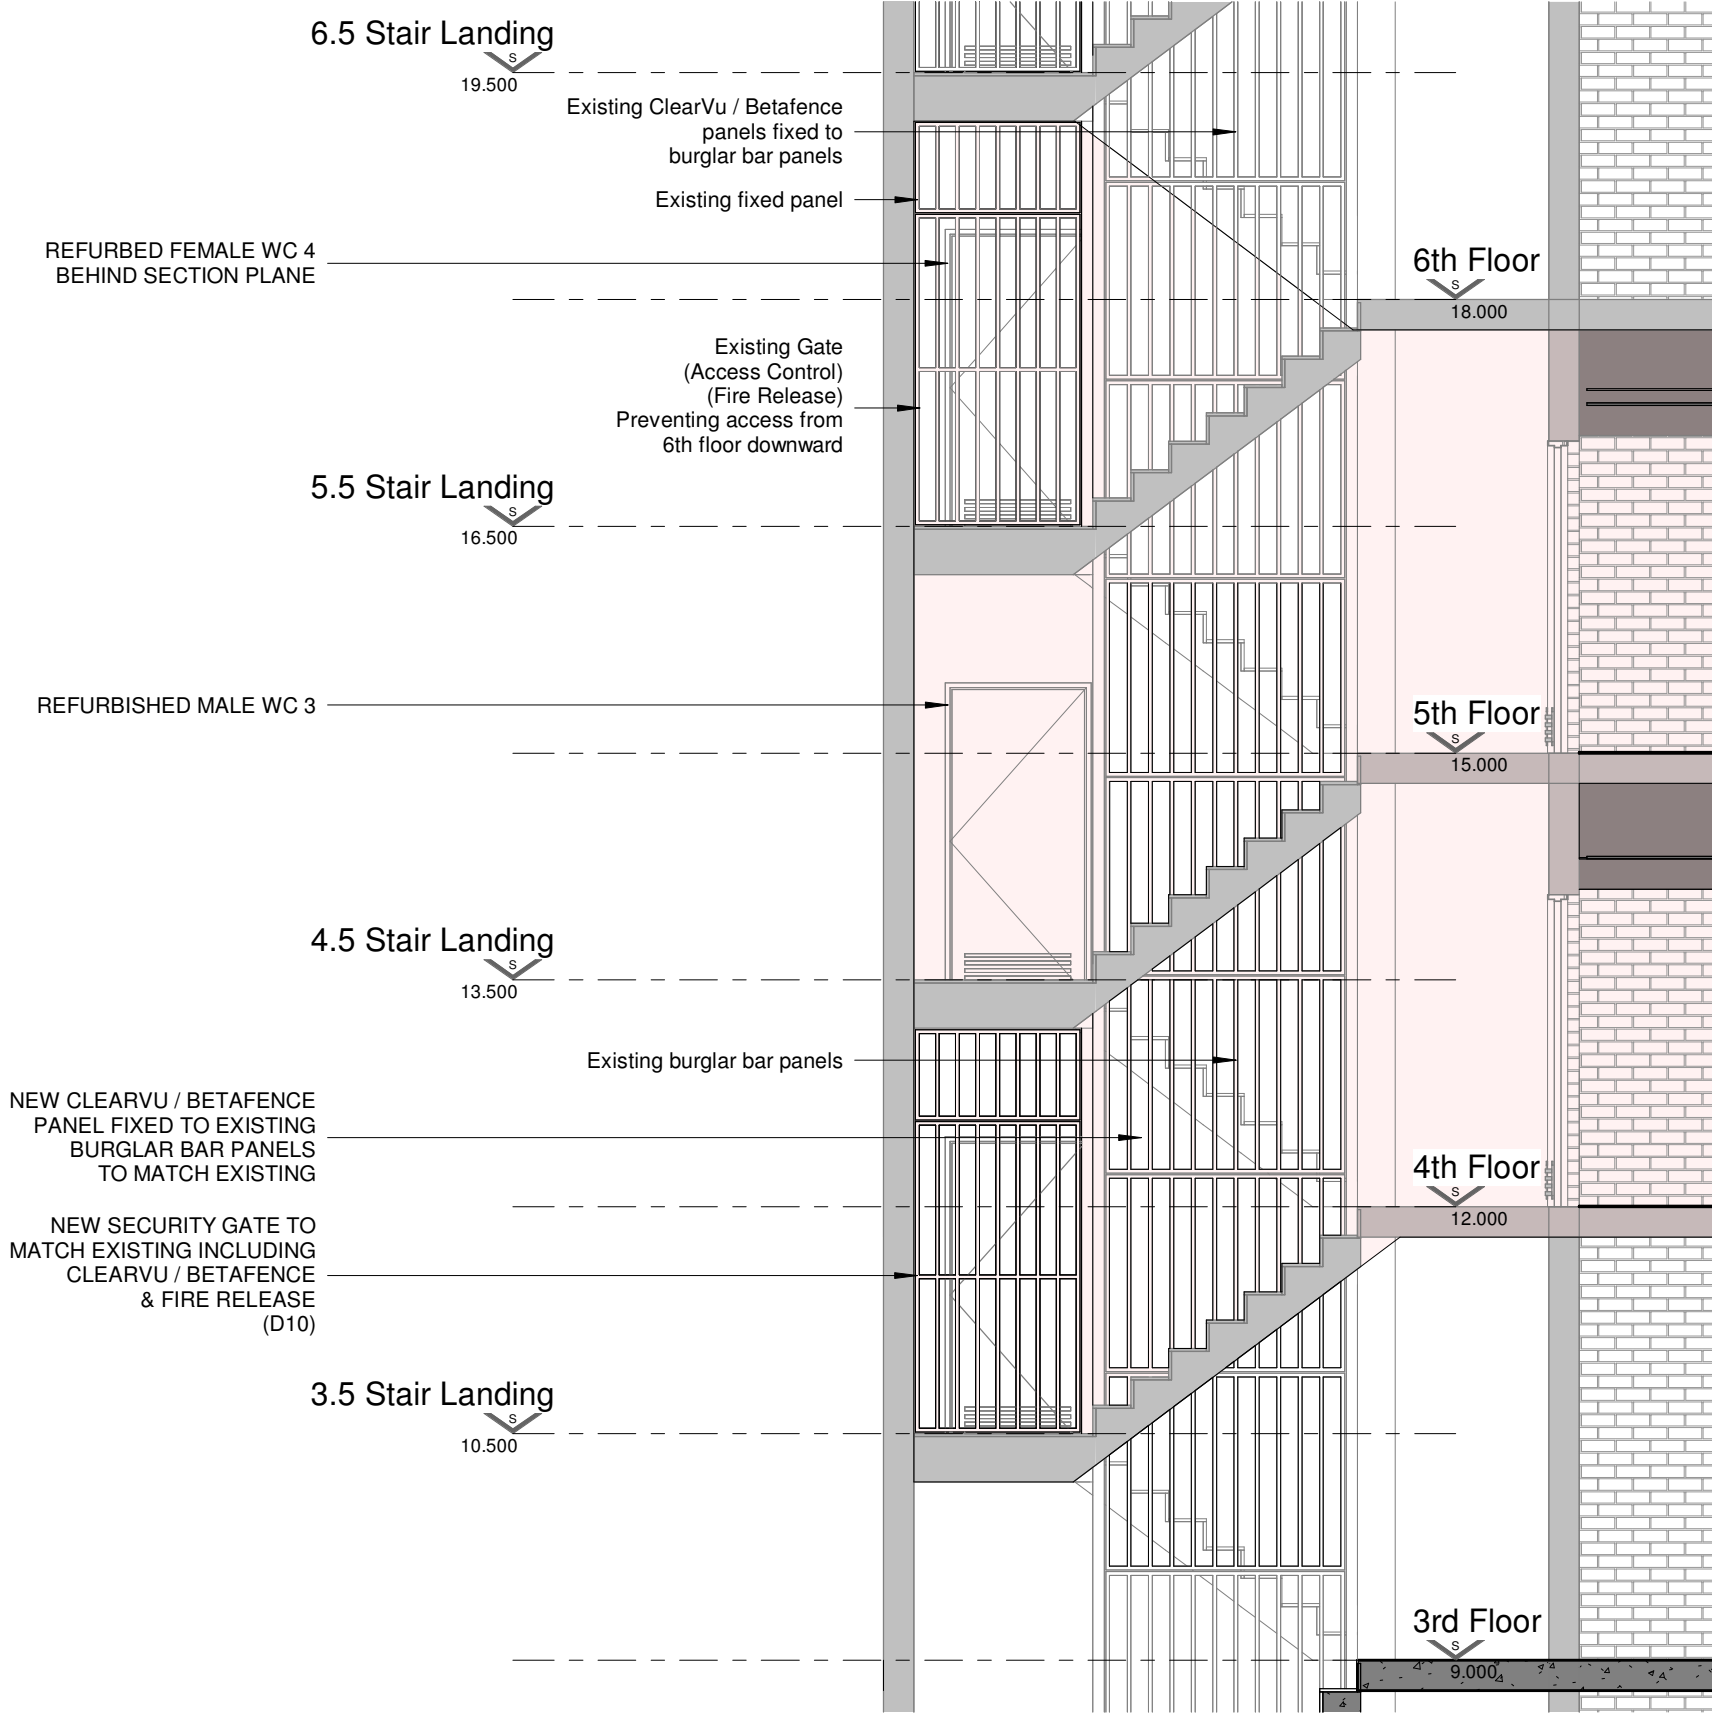


SECTION 3
1 : 50

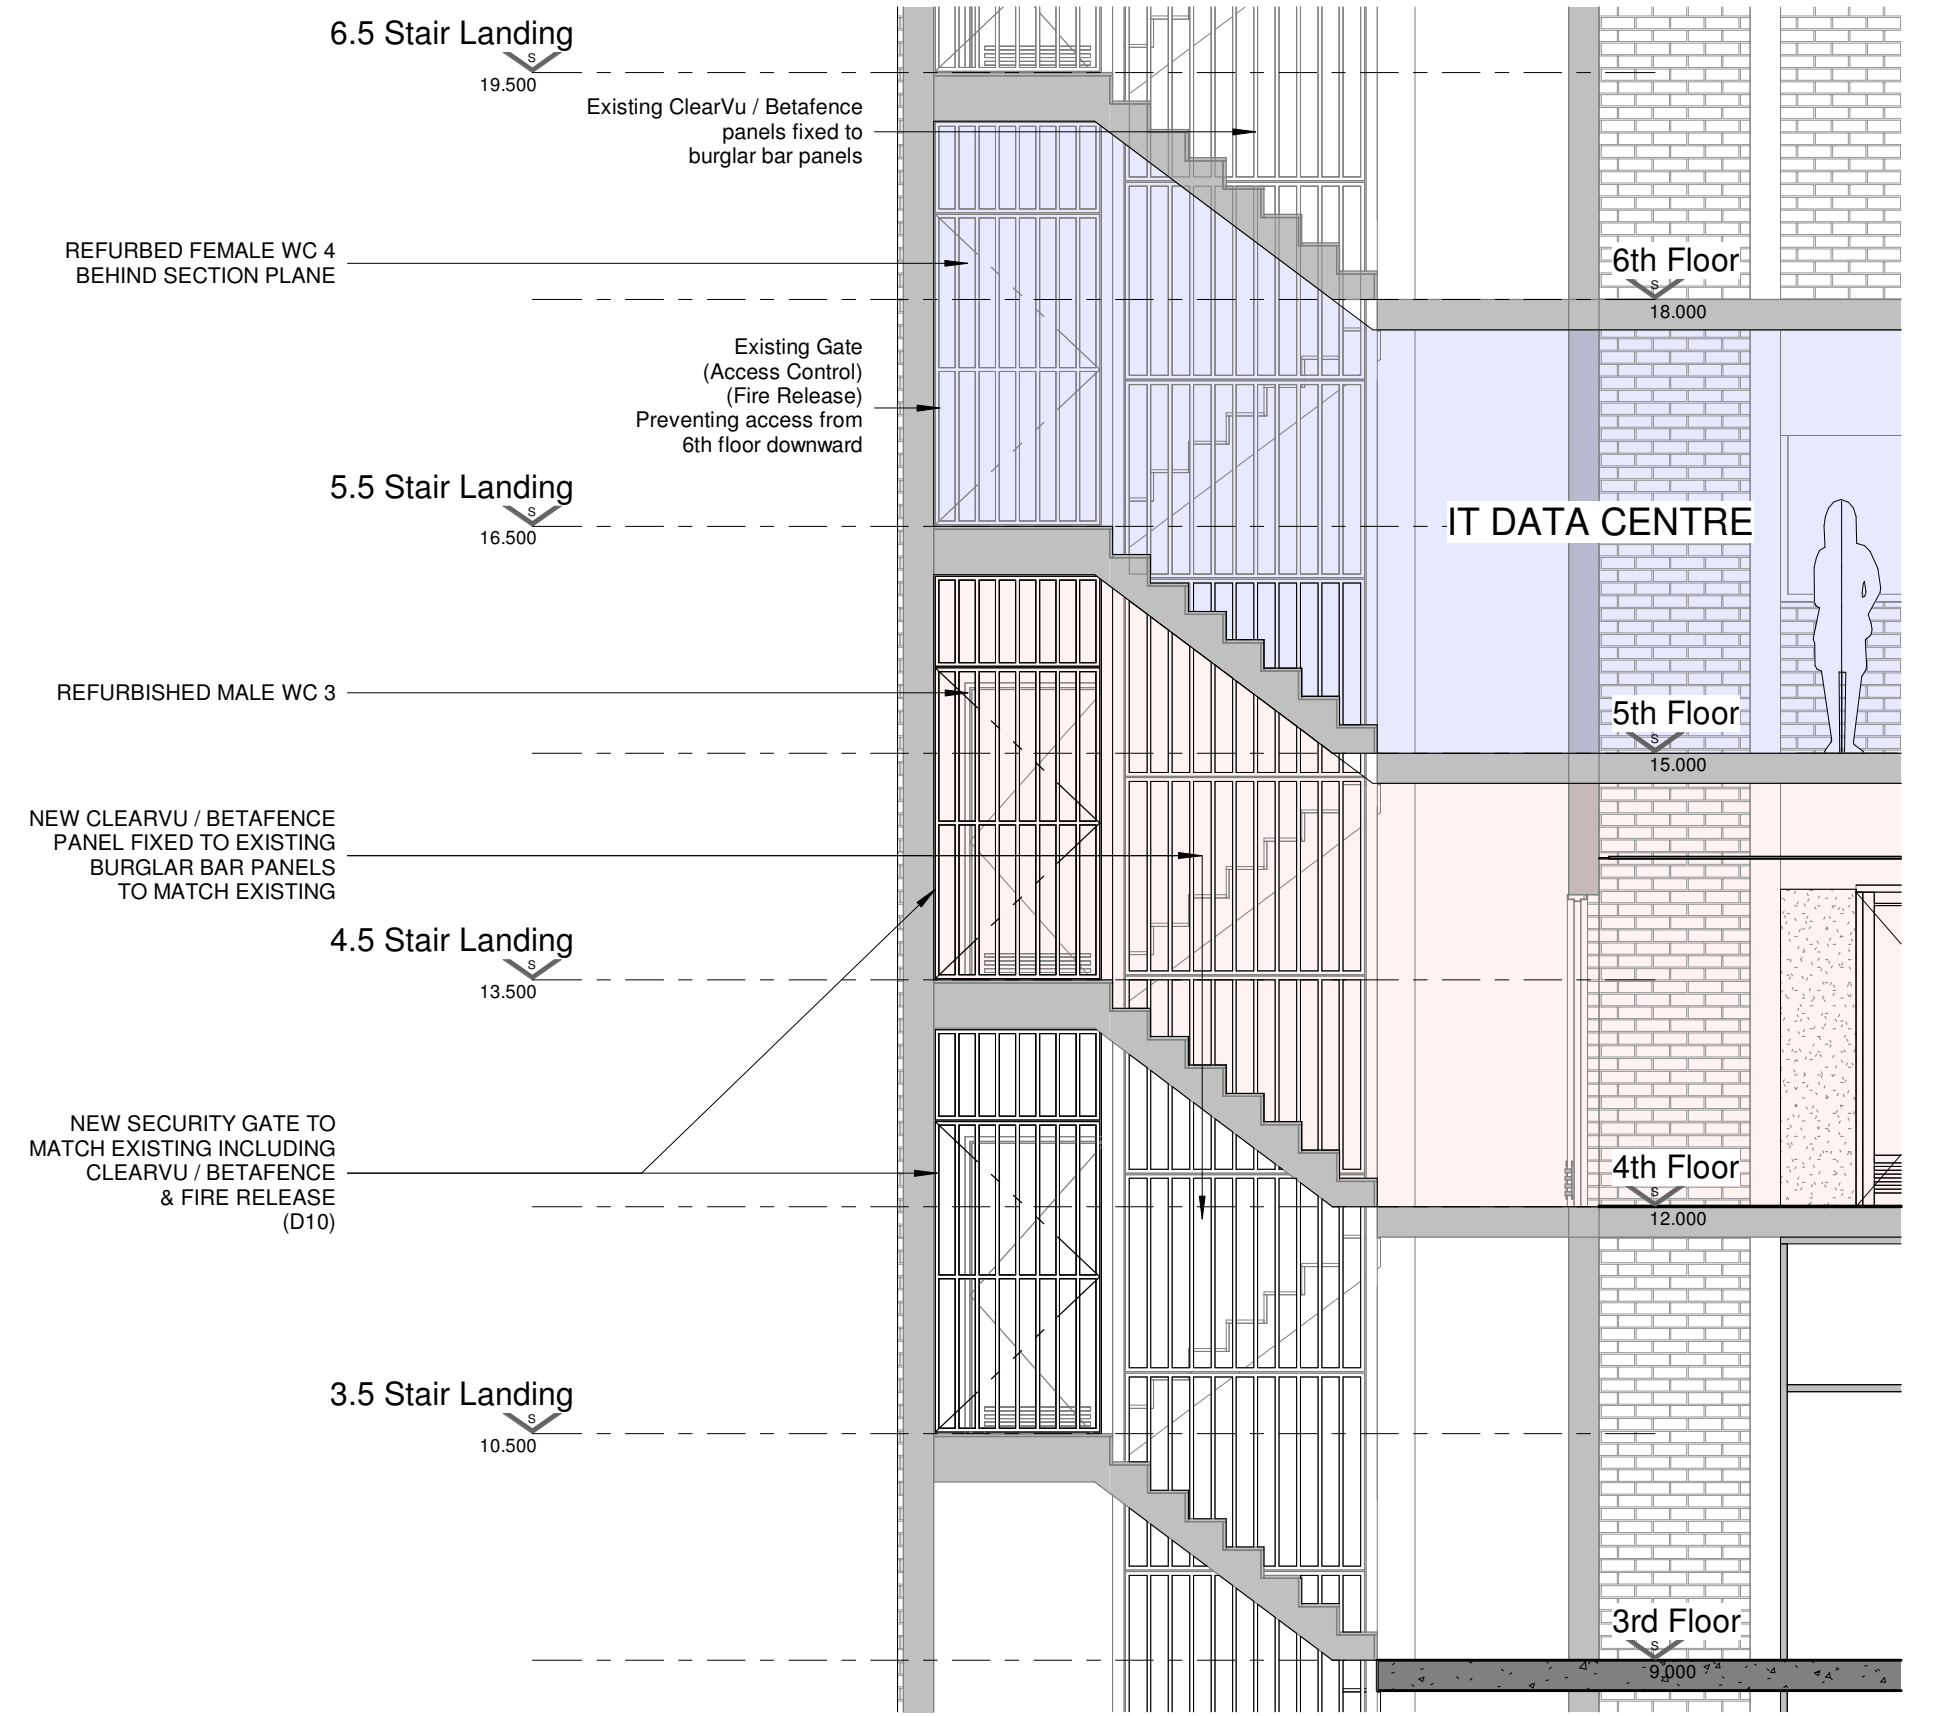


SECTION 4
1 : 50

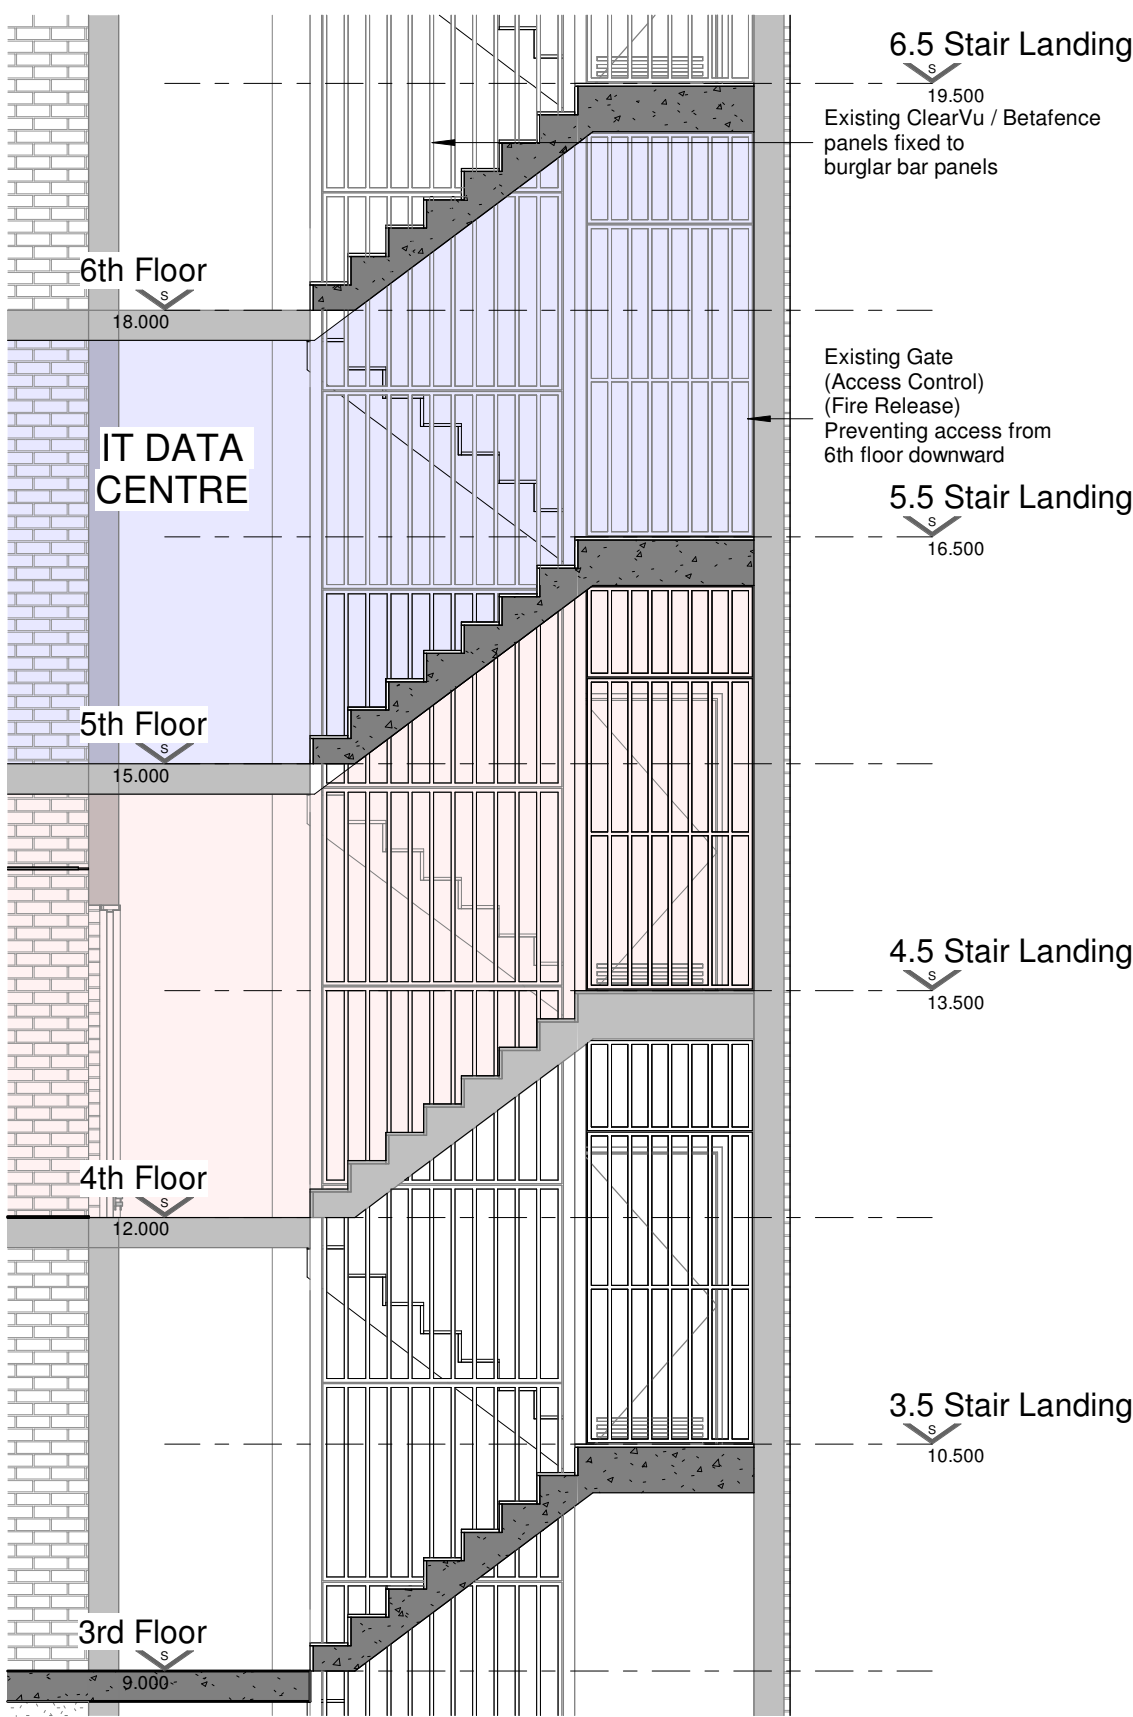

SECTION 5
1 : 50

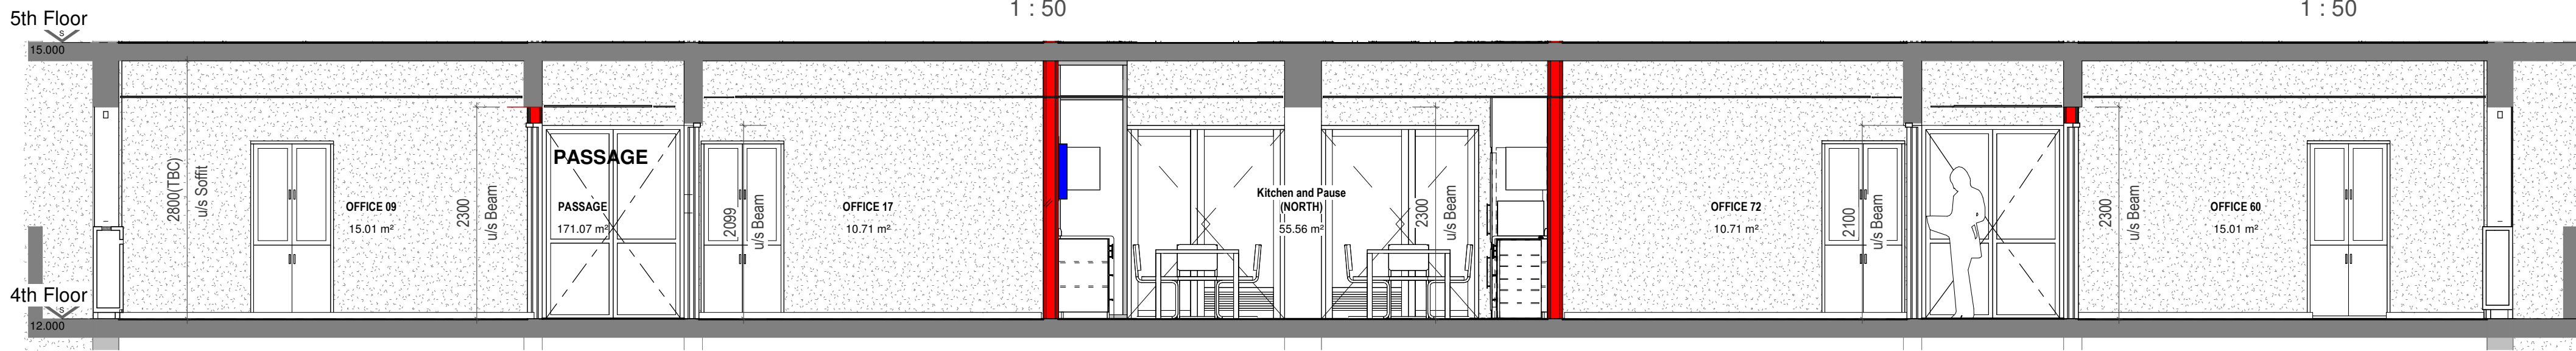

SECTION 1
1 : 50

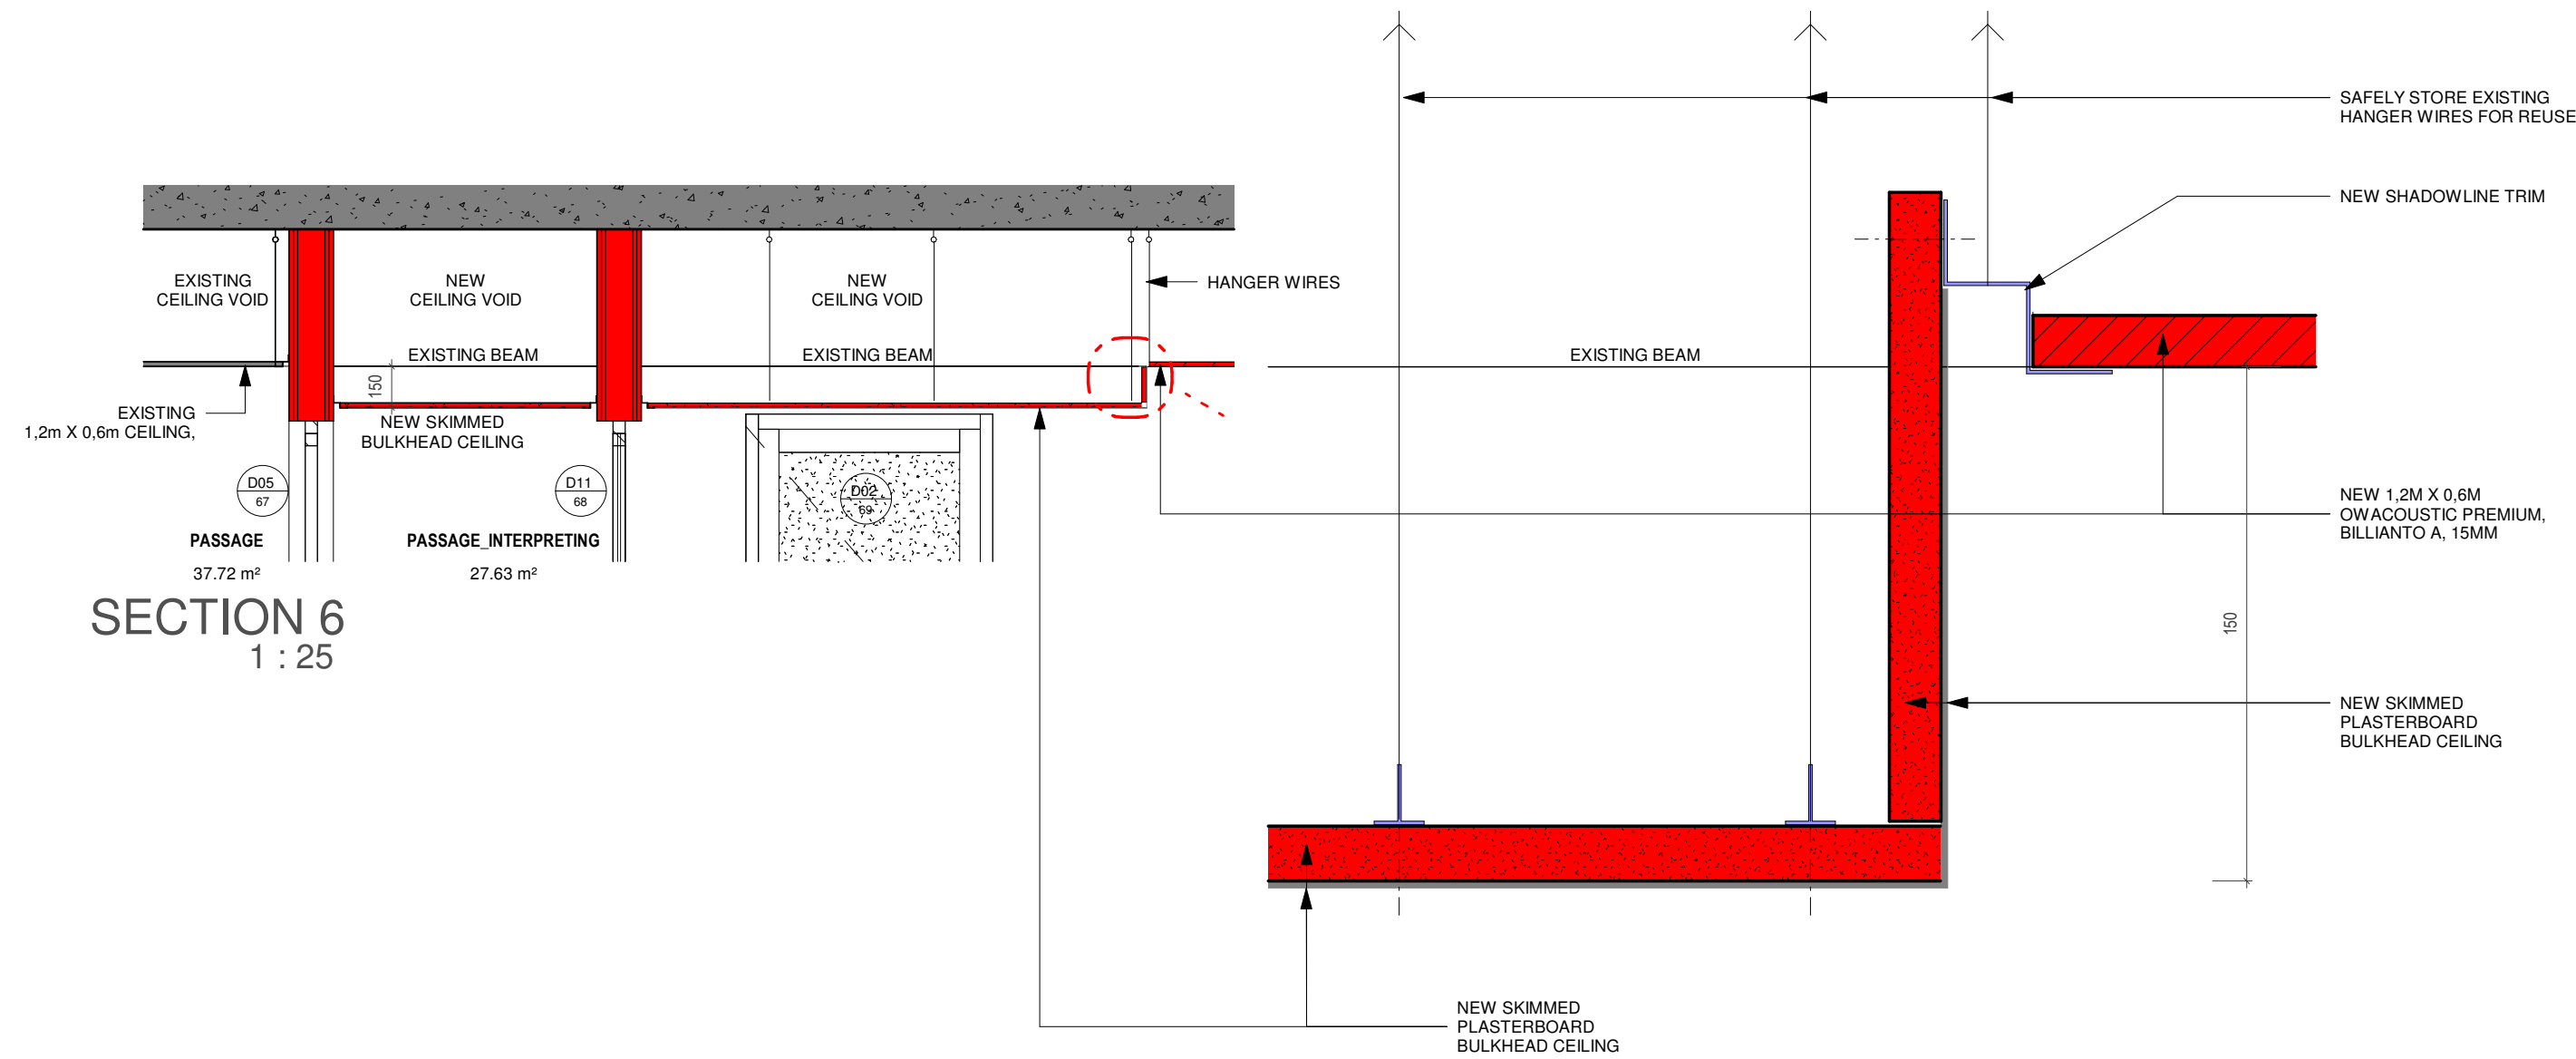

SECTION 6
1 : 25

DETAIL A
1 : 2

CLIENT:

DBSA
DEVELOPMENT BANK OF SOUTHERN AFRICA
Building Africa's Prosperity

LEAD CONSULTANT:



ruben reddy architects
Durban | Johannesburg | Cape Town | Bloemfontein | Polokwane
info@rubenreddyarch.co.za | www.rubenreddyarch.co.za

109_WP A.3 - Temporary Offices For Members
4th & 5th Flr_90 Plein Street

DESIGNED	DRAWN	CHECKED	APPROVED
RP	RJ	RP	RP

SECTIONS 1 - 6
4th & 5th FLOORS

TIME STAMP: 2023/12/12 10:51:27					As indicated @ A1		
INFORMATION		LA SUBMISSION		TENDER		CONSTRUCTION	
PROJECT NUMBER		ZONE		STAGE		ISSUE DATE	
109		A00		CON		2023-12-12	
DRAWING NUMBER						REVISION	
109-RRR-A00-XX-DR-02.00.000						1	
PROJECT NO.		ORIG.	ZONE	LEVEL	TYPE	DIS	SHEET NO.

AS-BUILT