



REV	DESCRIPTION	DRAWN	DATE
0	ISSUED FOR CONSTRUCTION		2023.05.30
1	NOGGING ADDED. TYPICAL OFFICE, Elevation A & Layout		2023.07.21
2	10+16 SEATER BOARDROOMS, SETOUT DIMENSIONS OF BOARDROOM TABLE LEGS FOR FLOORBOXES		2023.08.08

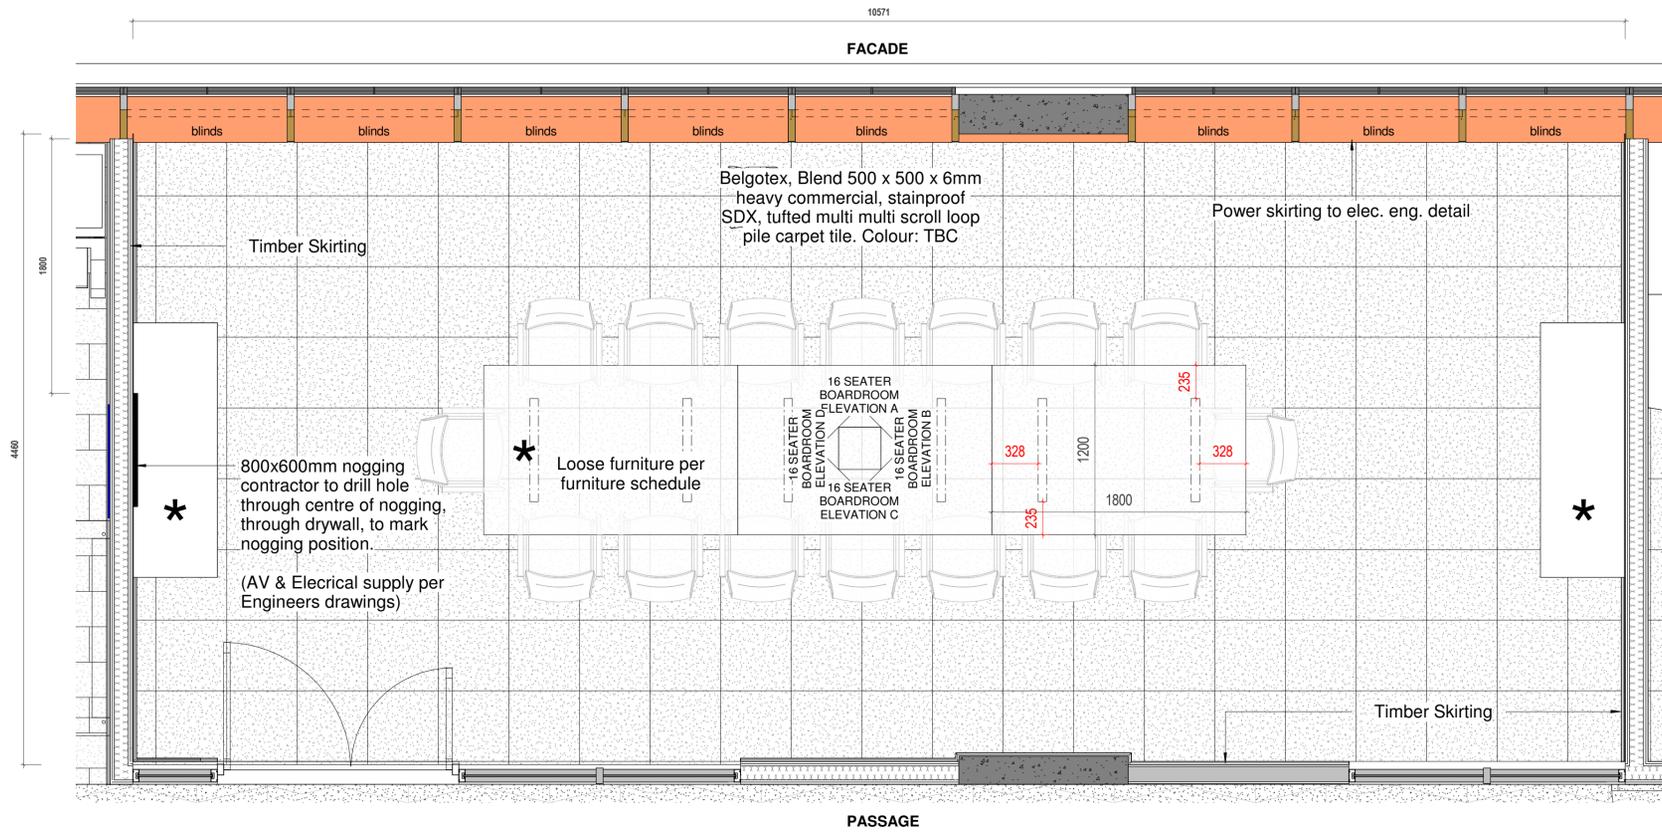

16 SEATER BOARDROOM LAYOUT
01.00.000 1 : 25

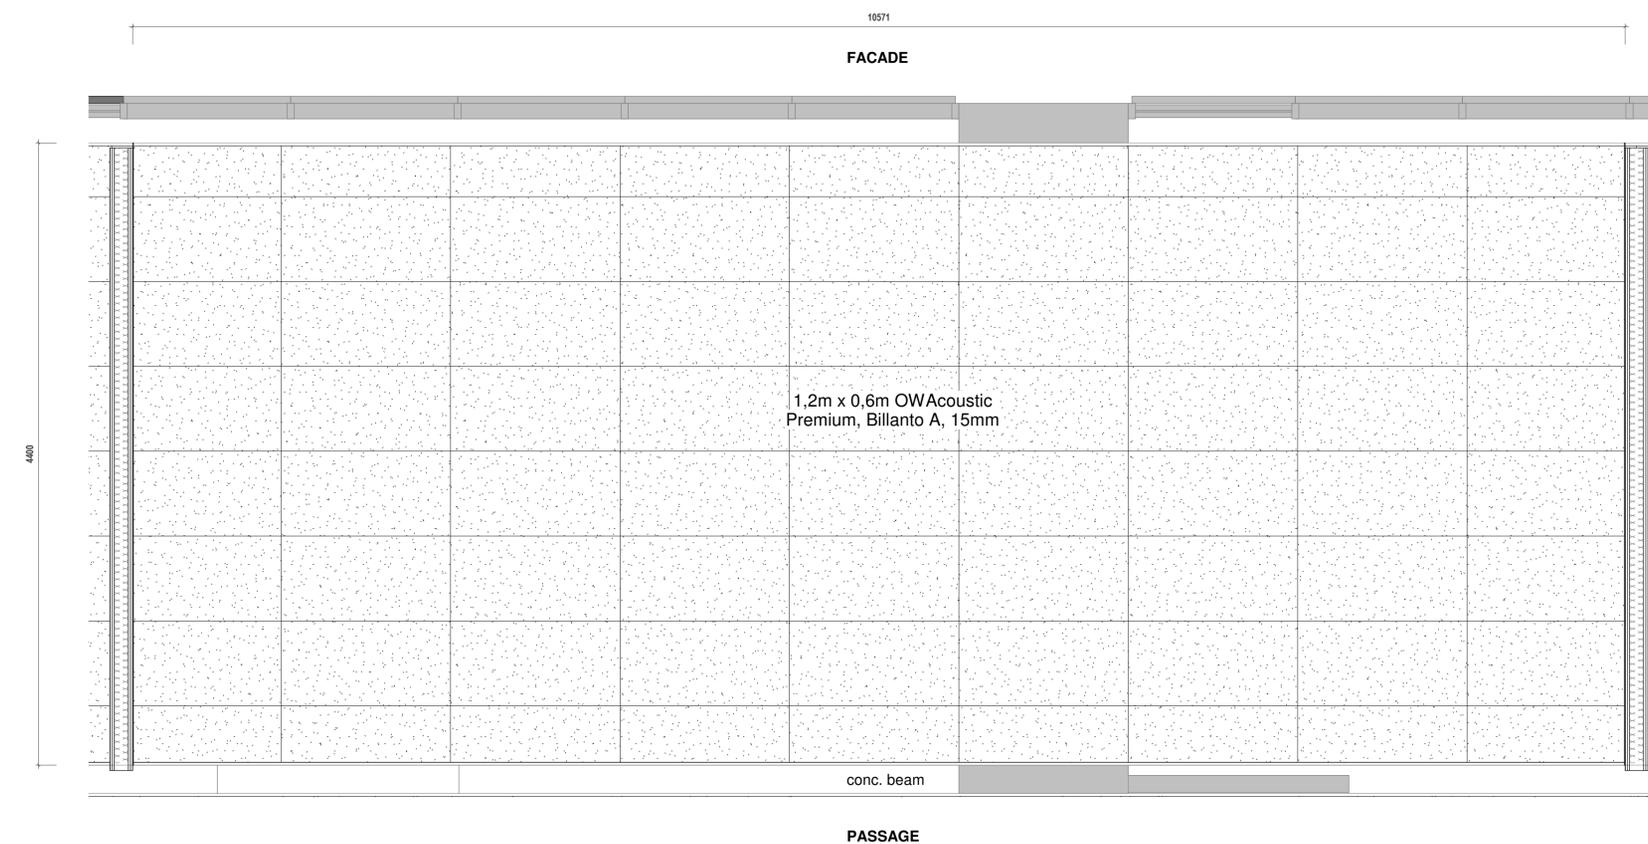

16 SEATER BOARDROOM CEILING PLAN
1 : 25

CLIENT:



LEAD CONSULTANT:



109_WP A.3 - Temporary Offices For Members
4th & 5th Flr_90 Plein Street

DESIGNED	DRAWN	CHECKED	APPROVED
RP	JVE	RP	RP

16 SEATER BOARDROOM PLANS DATA
4th&5th FLOORS

INFORMATION				CONSTRUCTION	
PROJECT NUMBER	ZONE	STAGE	ISSUE DATE	TENDER	CONSTRUCTION
109	A00	CON	2023.12.12		
DRAWING NUMBER					REVISION
109-RRA-A00-00-DR-04.00.004					2

AS-BUILT