



ISO A3 420mm x 297mm

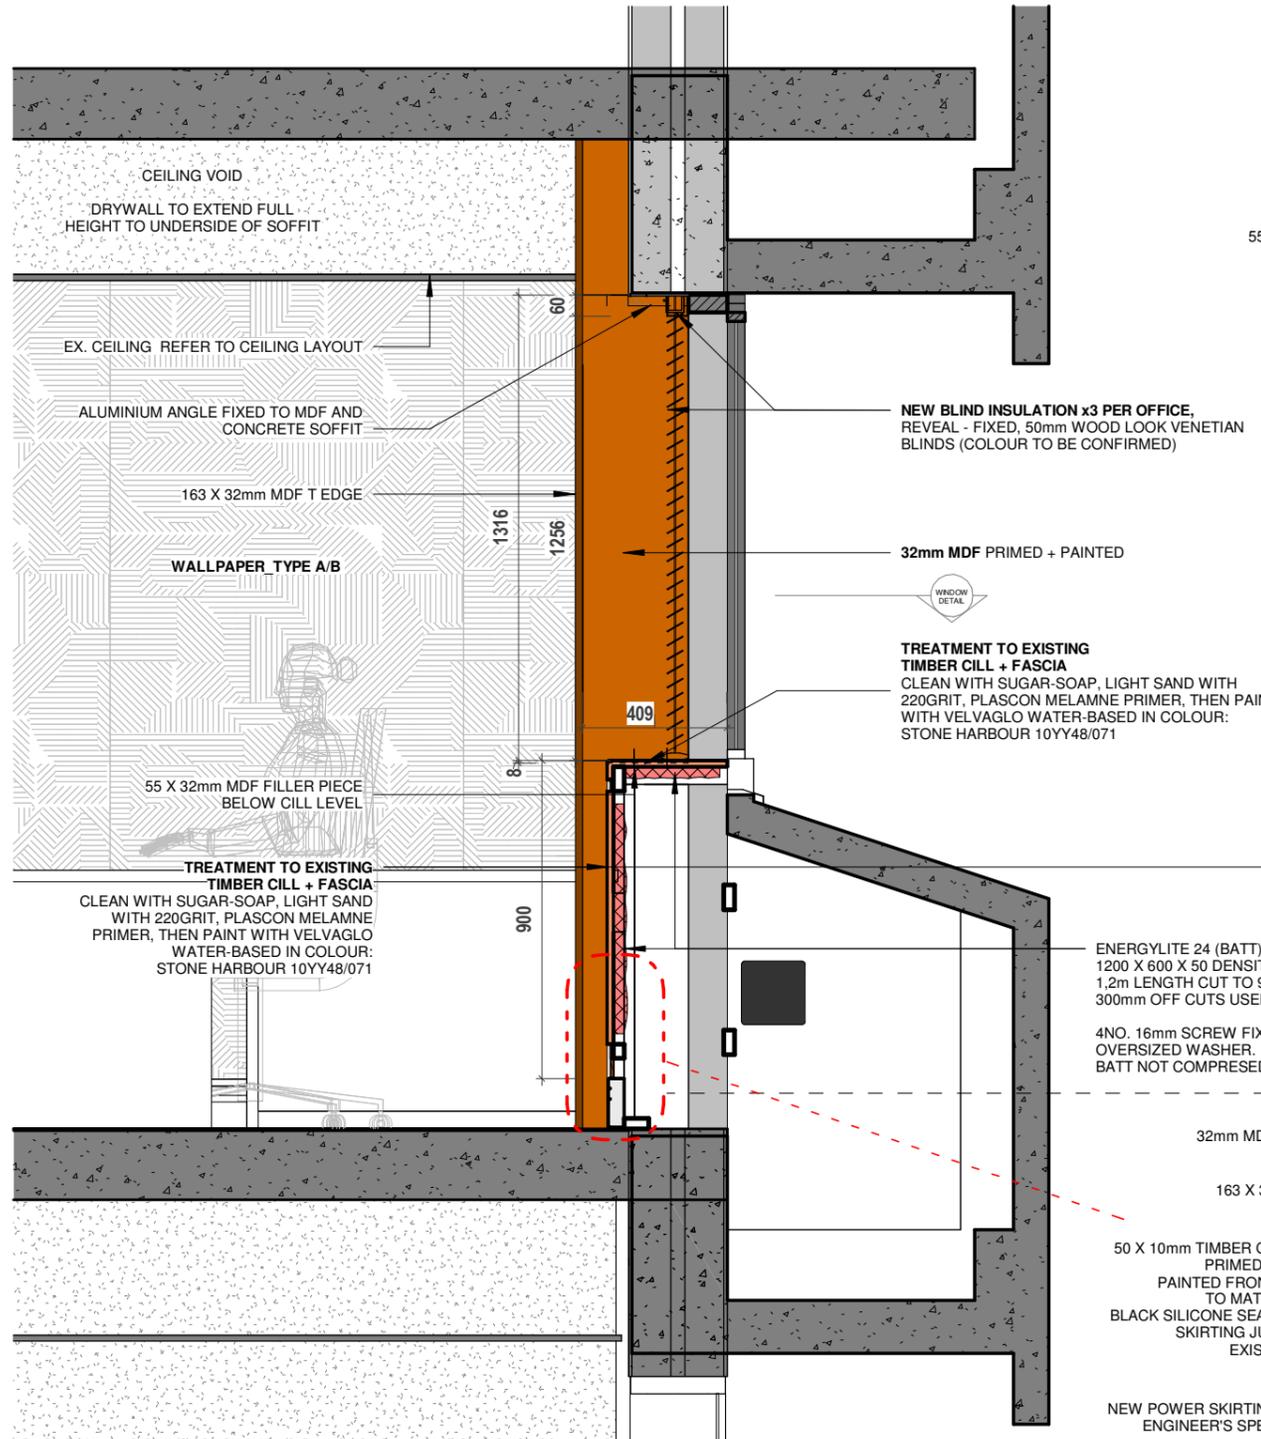

WINDOW DETAIL/SECTION
1 : 20

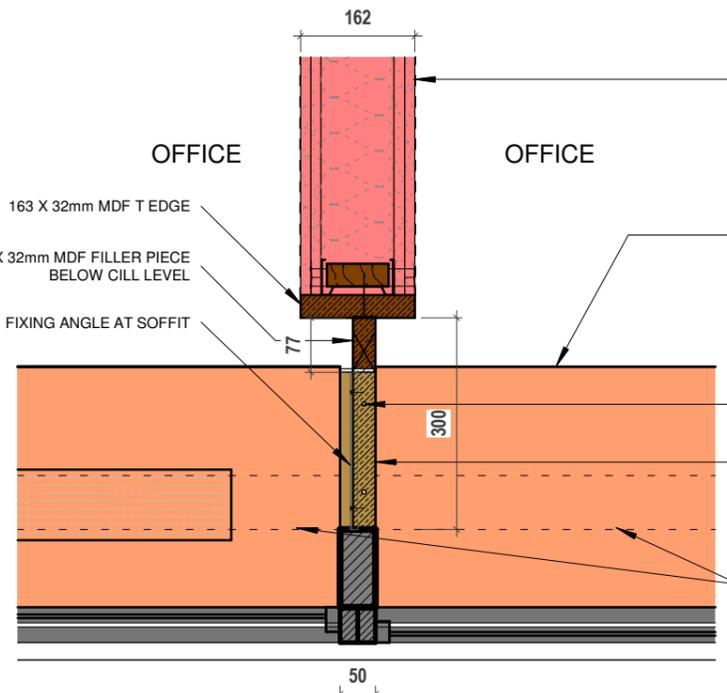

WINDOW DETAIL/PLAN
1 : 10

New 163mm GYPROC FIRE RESISTANT WALL SYSTEM, OR SIMILAR APPROVED (120min and 55dB). BOARD TYPE, STUD AND INSULATION TO MANUFACTURE'S SPECIFICATION AND DETAILS

TREATMENT TO EXISTING TIMBER CILL + FASCIA
CLEAN WITH SUGAR-SOAP, LIGHT SAND WITH 220GRIT, PLASCON MELAMNE PRIMER, THEN PAINT WITH VELVAGLO WATER-BASED IN COLOUR: STONE HARBOUR 10YY48/071

SCREWFIX THRU U/S EXIST. CILL REBATE

32mm MDF PRIMED + PAINTED

NEW BLIND INSULATION x3 PER OFFICE.
REVEAL - FIXED, 50mm WOOD LOOK VENETIAN BLINDS (COLOUR TO BE CONFIRMED)

NEW BLIND INSULATION x3 PER OFFICE.
REVEAL - FIXED, 50mm WOOD LOOK VENETIAN BLINDS (COLOUR TO BE CONFIRMED)

32mm MDF PRIMED + PAINTED

TREATMENT TO EXISTING TIMBER CILL + FASCIA
CLEAN WITH SUGAR-SOAP, LIGHT SAND WITH 220GRIT, PLASCON MELAMNE PRIMER, THEN PAINT WITH VELVAGLO WATER-BASED IN COLOUR: STONE HARBOUR 10YY48/071

ENERGYLITE 24 (BATT) 14602
1200 X 600 X 50 DENSITY
1.2m LENGTH CUT TO 900mm
300mm OFF CUTS USED AT U/S CILL


4NO. 16mm SCREW FIXING WITH OVERSIZED WASHER.
BATT NOT COMPRESSED FULLY.

32mm MDF PRIMED + PAINTED

163 X 32mm MDF T EDGE

50 X 10mm TIMBER COVER STRIP, PRIMED BOTH SIDES, PAINTED FRONT SIDE ONLY TO MATCH EXISTING. BLACK SILICONE SEAL TO POWER SKIRTING JUNCTION AND EXISTING FASCIA.

NEW POWER SKIRTING TO ELEC. ENGINEER'S SPECIFICATION

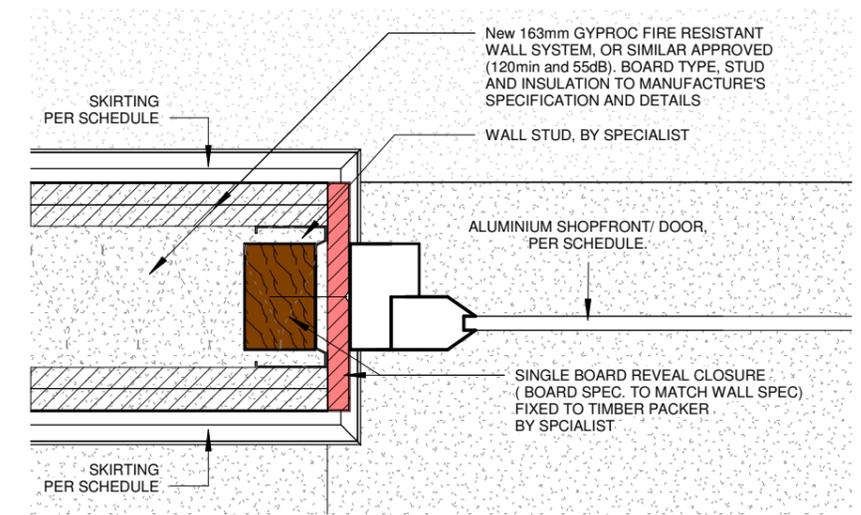

TYPICAL PARTITION CLOSURE/ END
1 : 5

BATTEN @ POWER SKIRTING
05.00.000 1 : 5

AS-BUILT



ruben reddy architects

Durban | Johannesburg | Cape Town | Bloemfontein | Polokwane
info@rubenreddyarch.co.za | www.rubenreddyarch.co.za

REV	DESCRIPTION	DATE
0	ISSUED FOR CONSTRUCTION	2023.05.30
1	REVISED TREATMENT SPEC. OF EXISTING WINDOW CILL + FASCIA	2023.06.02
2	WINDOW DETAIL + PARTITION CLOSURE/ END CAP	2023.06.08
3	WINDOW DETAIL_38X38 PAR SA PINE BATTEN@POWER SKIRTING	2023.07.27
4	WINDOW DETAILS_TIMBER COVER STRIP @ POWER SKIRTING	2023.08.08

109_WP A.3 - Temporary Offices For Members			
DESIGNED	DRAWN	CHECKED	APPROVED
RP	KP	RP	RP

TIME STAMP: 2023/12/12 12:30:39		As indicated @ A3	
INFORMATION	L.A SUBMISSION	TENDER	CONSTRUCTION
PROJECT NUMBER	ZONE	STAGE	ISSUE DATE
109		CON	2023-12-12
DRAWING NUMBER			REVISION
109-RRR-05.00.000			4
PROJECT NO.	ORIG.	ZONE	LEVEL
			TYPE
			DIS
			SHEET NO.