




elevators are to the right
when facing these doors

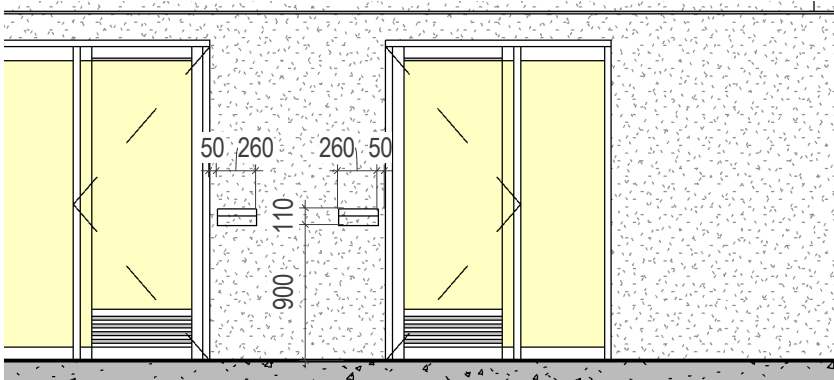

elevators are to the left
when facing these doors

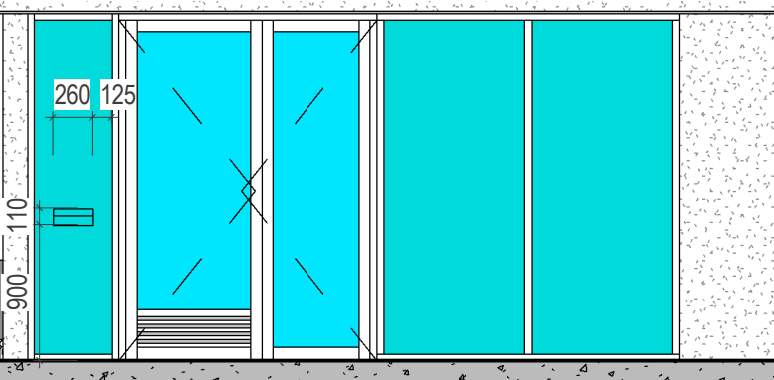


WALL SETTING OUT
1 : 50

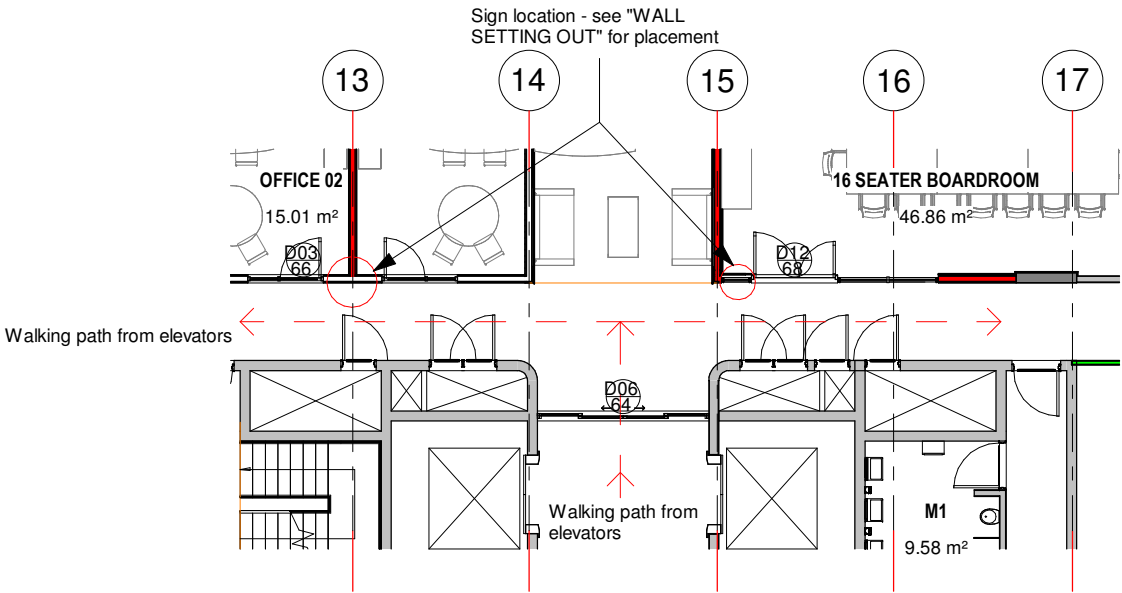

TYPICAL SIGNAGE LOCATION
02.00.000 1 : 150

- SIGNS WILL ALWAYS BE PLACED ON WALL NEXT TO DOOR UNLESS OTHERWISE INDICATED (BOARDROOMS).
- DOOR SIGNS FOR THE INTERPRETATING ROOMS ARE PLACED WHERE INDICATED ON PLAN.
- FOR ALL DOOR SIGN TYPES, REFER TO SCHEDULE.

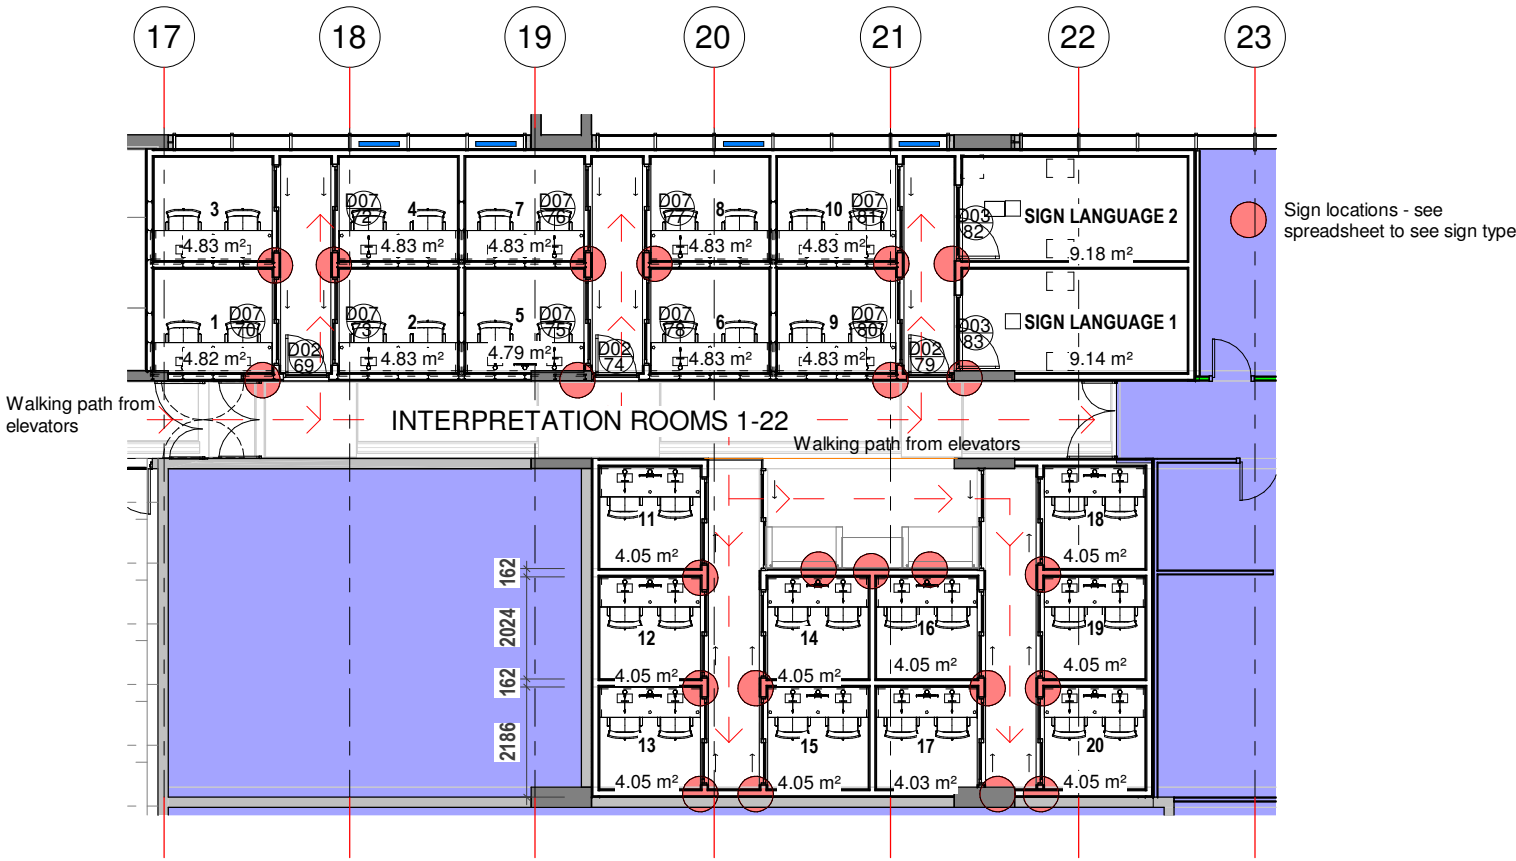

5th FLOOR INTERPRETATION SIGNAGE LOCATION
02.00.000 1 : 150

AS-BUILT

REV	DESCRIPTION	DATE
0	ISSUED FOR CONSTRUCTION	2023.05.30
1	SIGNAGE DETAILS UPDATED	2023.07.18
2	SIGNAGE INFORMATION UPDATED	2023.09.13

109_WP A.3 - Temporary Offices For Members

DESIGNED	DRAWN	CHECKED	APPROVED
RP	JVE	RP	RP

SIGNAGE SETTING OUT & TYPICAL
LOCATIONS

TIME STAMP: 2023/12/12 12:40:52

As indicated @ A3

INFORMATION	L.A SUBMISSION	TENDER	CONSTRUCTION
PROJECT NUMBER	ZONE	STAGE	ISSUE DATE
109		CON	2023-12-12

DRAWING NUMBER		REVISION
109-RRR-DR-05.01.000		2