


EXISTING DOORS  
FOR RECORD PURPOSES ONLY

EXISTING FIRE DOOR -  
ACCESS CONTROL, PANIC  
IRONMONGERY AND RELEASE  
TRIGGER

D01

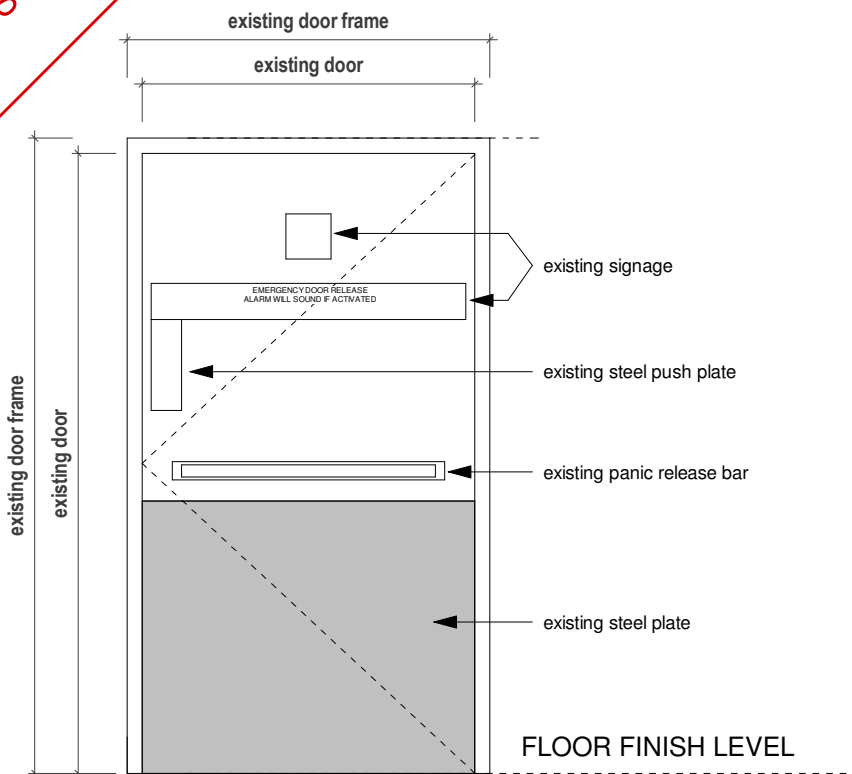

AS-BUILT

DESCRIPTION	: Existing timber Fire Door
FRAME	: Existing timber frame
HINGES	: N/A
GLAZING	: N/A
IRONMONGERY	: N/A
SIGNAGE	: N/A
NO.	: Inside Opening 3no. Left Handed Inside Opening 3no. Right Handed

#### GENERAL NOTES

Door swings and positions to be calculated from the door reference plans.  
All dimensions are to be checked on site by the contractor prior to construction.  
Any discrepancies on this drawing are to be reported to the office of the architect prior to construction.  
All aluminium and steel is to be isolated from one another to prevent galvanic action.  
All quantities are to be checked on site by the contractor prior to placing orders.  
All undercutting of doors is to be calculated from mechanical detailed construction drawings.  
All shop front doors are to be AAAMSA approved.

#### COPYRIGHT NOTE

This drawing is subject to copyright and may not be reproduced, in whole or part, or in any manner whatsoever without written permission from the architect

 **ruben reddy architects**

2nd-3rd floors / 110 Long Street / Cape Town / South Africa  
8001 / Tel: +27(0)21 426 0969 / Fax: +27(0)21 424 5323

Client:

**DBSA**  
DEVELOPMENT BANK OF SOUTHERN AFRICA  
Building Africa's Prosperity

Lead:

**DUPATI**  
CONSULTING

Drawing No.: 06.01.001

Scale: 1 : 25

Date issued: 2023.12.12

Drawn: KP

Rev.: 0