



FOR GENERAL NOTES REFER TO DRAWING NUMBER : 2020\_RR00-RR4-A00-XX-NB-4-10.00.00


REV	DESCRIPTION	DRAWN	DATE
0	ISSUED FOR CONSTRUCTION		2023.05.30
1	REVISED TREATMENT SPEC. OF EXISTING WINDOW CILL + FASCIA		2023.06.02
2	NOGGING ADDED. TYPICAL OFFICE, Elevation A & Layout		2023.07.21
3	SKIRTING TERMINATION @ DOORS		2023.08.01

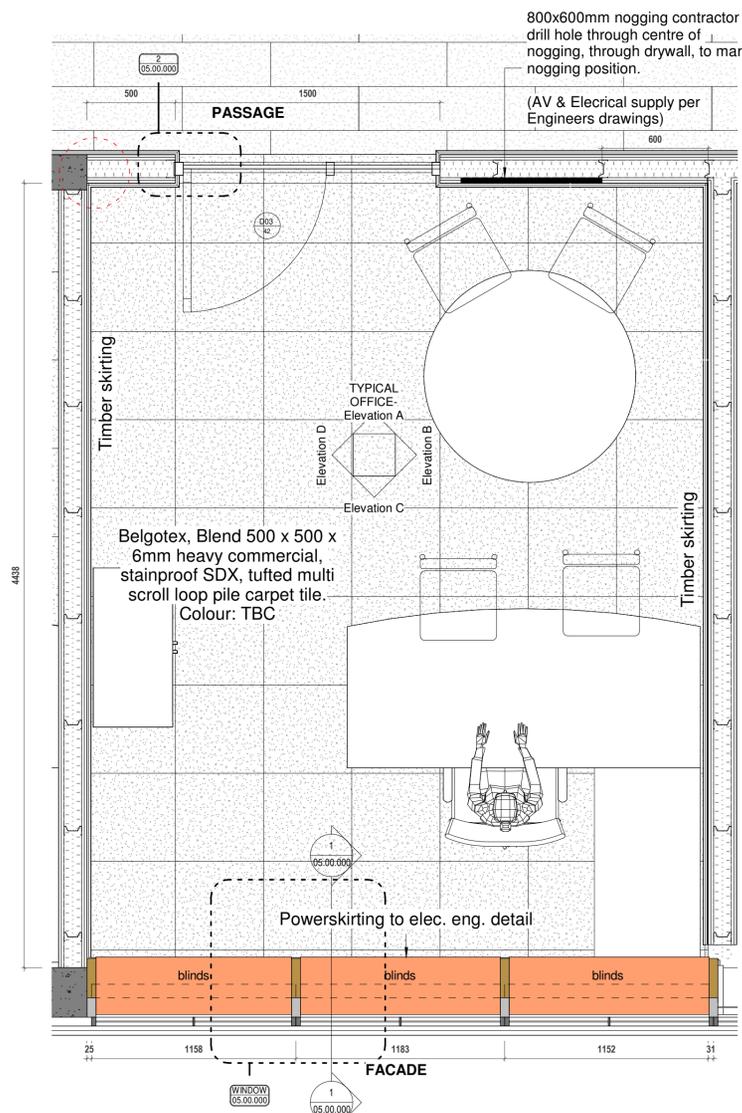

TYPICAL OFFICE LAYOUT  
1 : 20

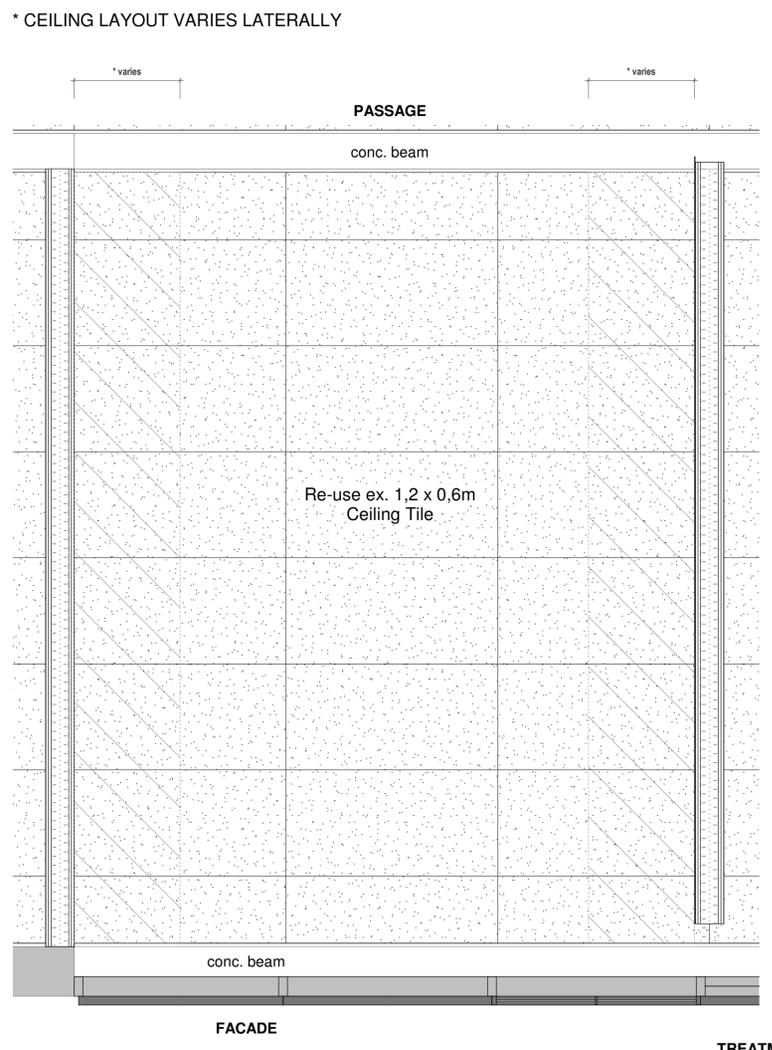


TYPICAL OFFICE CEILING PLAN  
1 : 20

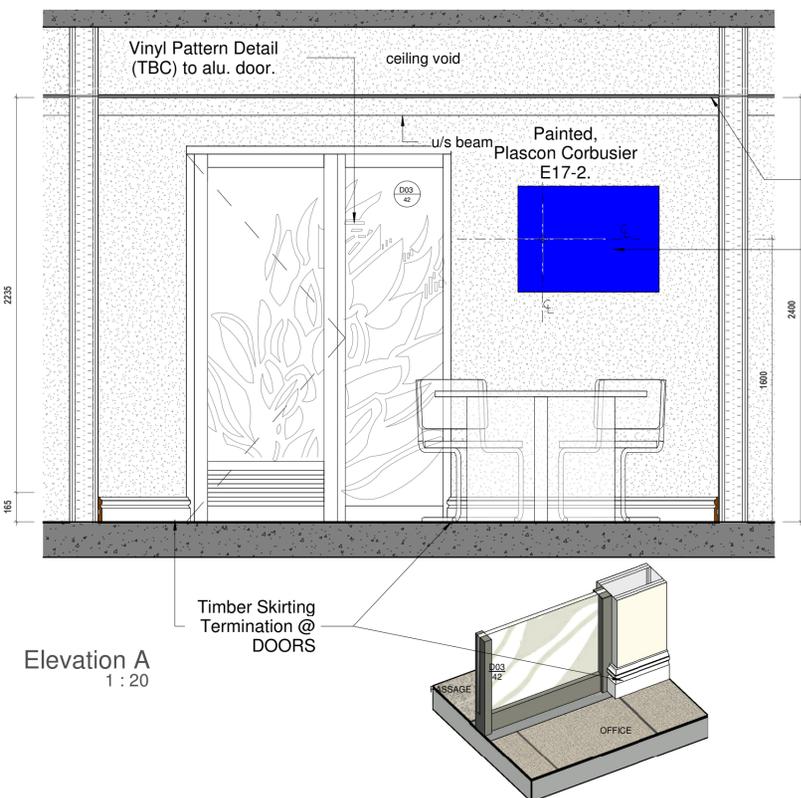

- Ex. ceiling to be cut + made good @ new partition  
- New shadowline cornice

800x600mm nogging contractor to drill hole through centre of nogging, through drywall, to mark nogging position.  
(AV & Electrical supply per Engineers drawings)

TREATMENT TO EXISTING  
TIMBER CILL + FASCIA  
CLEAN WITH SUGAR-SOAP, LIGHT SAND WITH 220GRIT, PLASCON MELAMNE PRIMER, THEN PAINT WITH VELVAGLO WATER-BASED IN COLOUR: STONE HARBOUR 10YY48/071


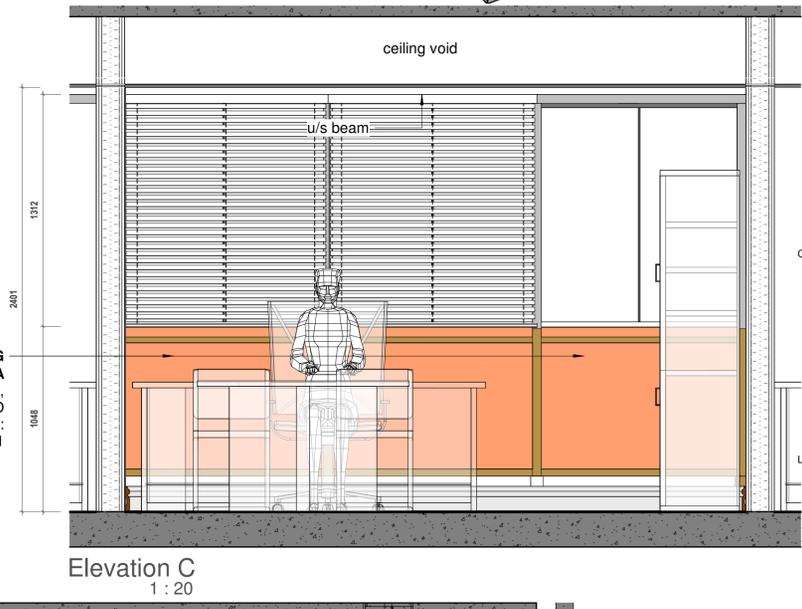


CLIENT:

**DBSA**  
DEVELOPMENT BANK OF SOUTHERN AFRICA  
*Building Africa's Prosperity*

LEAD CONSULTANT:

**DURAPI**  
CONSULTING

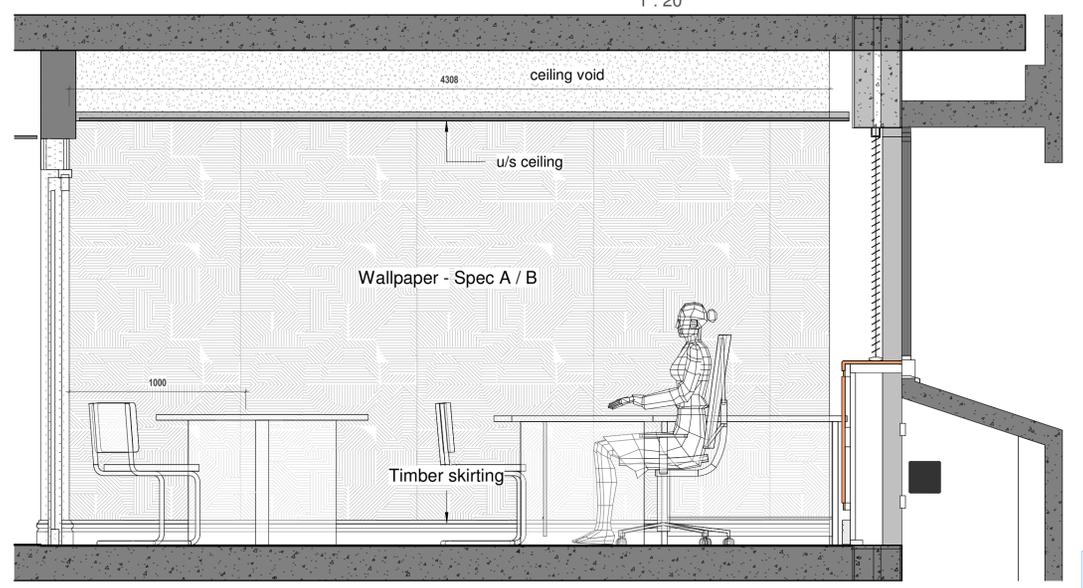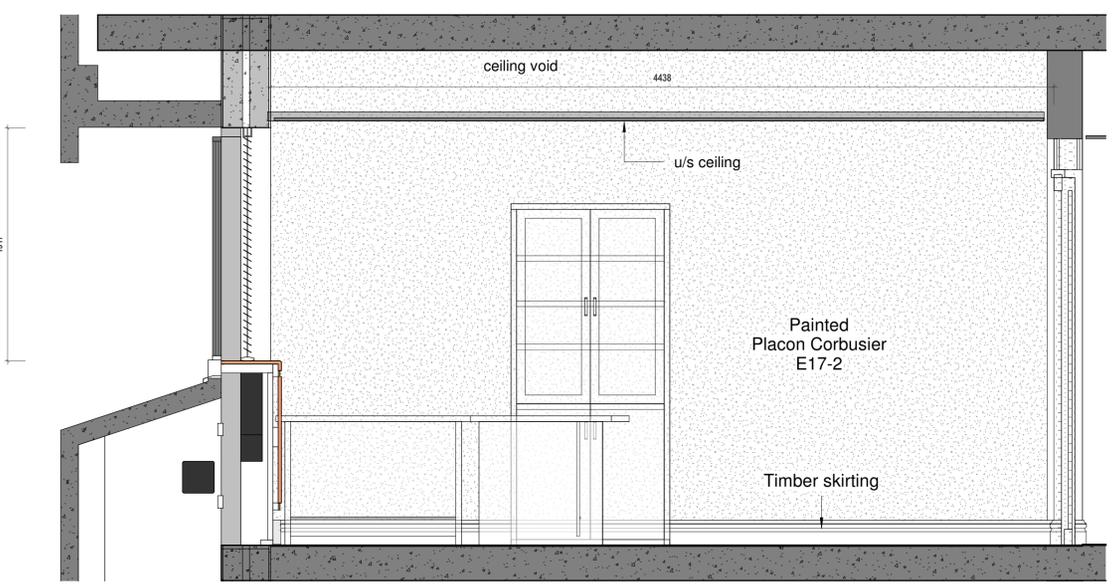

ruben reddy architects  
Durban | Johannesburg | Cape Town | Bloemfontein | Polokwane  
info@rubenreddyarch.co.za | www.rubenreddyarch.co.za

109\_WP A.3 - Temporary Offices For Members  
4th & 5th Flr\_90 Plein Street

DESIGNED	DRAWN	CHECKED	APPROVED
RP	JVE	RP	RP

TYPICAL OFFICE DATA SHEET  
4th&5th FLOORS

INFORMATION	LA SUBMISSION	TENDER	CONSTRUCTION
PROJECT NUMBER	ZONE	STAGE	ISSUE DATE
109	A00	CON	2023.12.12
DRAWING NUMBER			REVISION
109-RR4-A00-XX-DR-04.00.001			3

AS-BUILT