



REV	DESCRIPTION	DRAWN	DATE
0	ISSUED FOR CONSTRUCTION		2023.05.30
1	REVISED TREATMENT SPEC. OF EXISTING WINDOW CILL + FASCIA		2023.06.02
2	NOGGING ADDED. TYPICAL OFFICE, Elevation A & Layout		2023.07.21
3	10+16 SEATER BOARDROOMS. SETOUT DIMENSIONS OF BOARDROOM TABLE LEGS FOR FLOORBOXES		2023.08.08

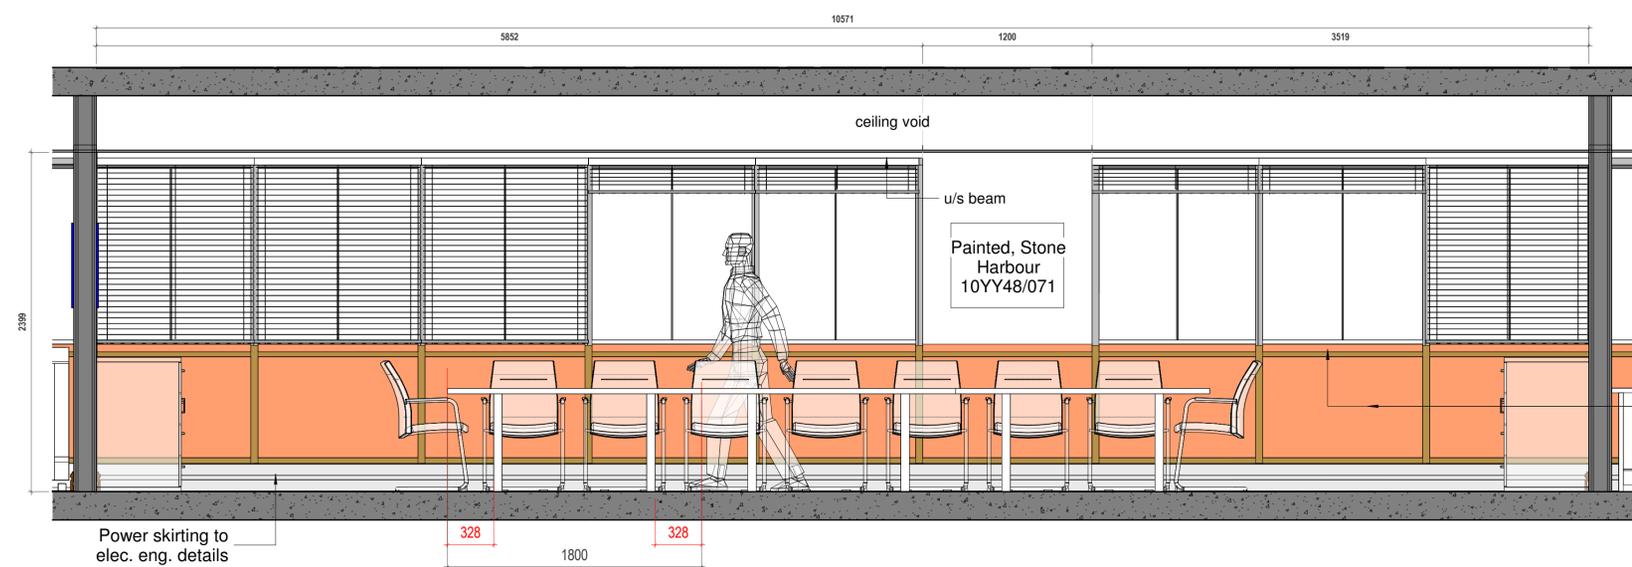


**TREATMENT TO EXISTING
TIMBER CILL + FASCIA**
CLEAN WITH SUGAR-SOAP, LIGHT SAND WITH 220GRIT, PLASCON MELAMNE PRIMER, THEN PAINT WITH VELVAGLO WATER-BASED IN COLOUR: STONE HARBOUR 10YY48/071


ELEVATION A
04.00.004 1 : 25

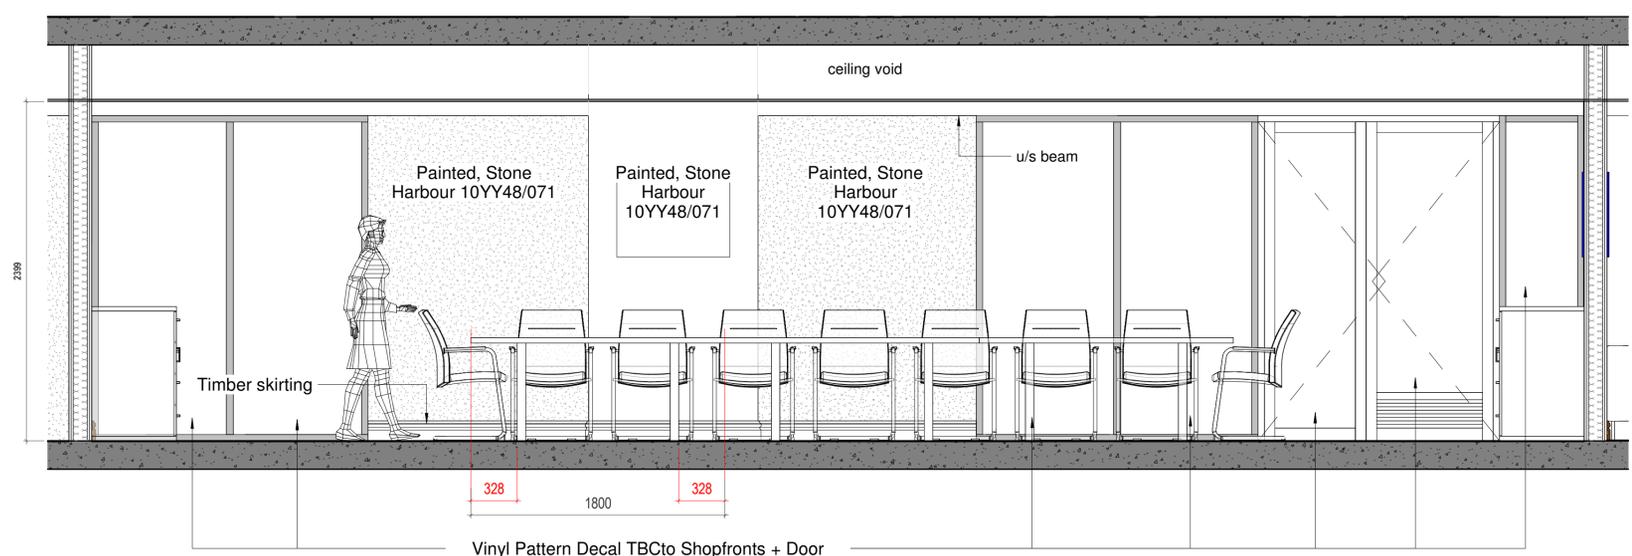

ELEVATION C
04.00.004 1 : 25

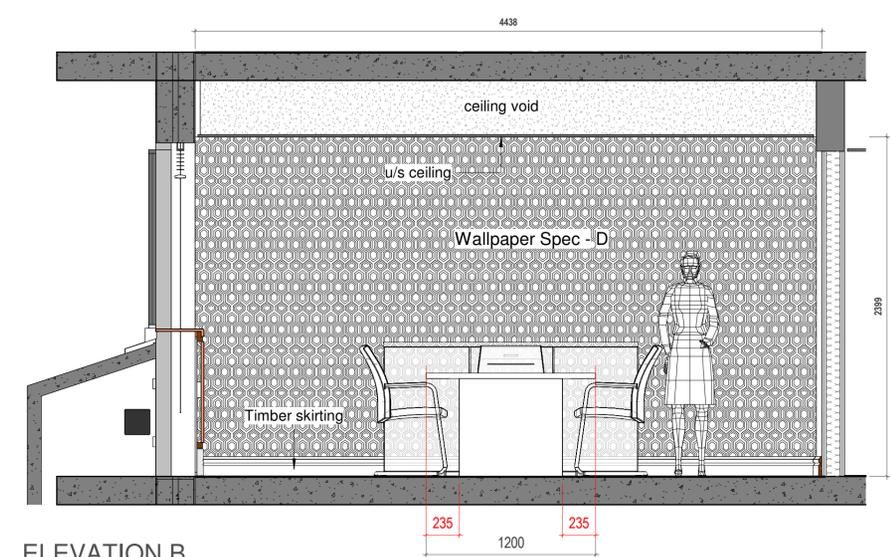

ELEVATION B
04.00.004 1 : 25

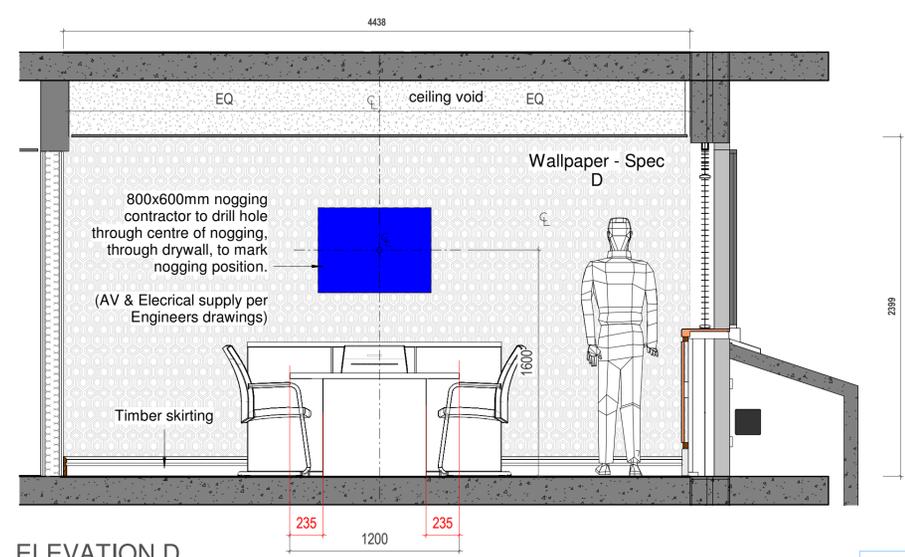

ELEVATION D
04.00.004 1 : 25

CLIENT:

DBSA
DEVELOPMENT BANK OF SOUTHERN AFRICA
Building Africa's Prosperity

LEAD CONSULTANT:

DURAPI
CONSULTING

ruben reddy architects
Durban | Johannesburg | Cape Town | Bloemfontein | Polokwane
info@rubenreddyarch.co.za | www.rubenreddyarch.co.za

109_WP A.3 - Temporary Offices For Members
4th & 5th Fir_90 Plein Street

DESIGNED	DRAWN	CHECKED	APPROVED
RP	JVE	RP	RP

16 SEATER BOARDROOM
ELEVATIONS DATA
4th&5th FLOORS

TIME STAMP: 2023/12/12 11:55:53 1 : 25 @ A1

INFORMATION	LA SUBMISSION	TENDER	CONSTRUCTION
PROJECT NUMBER	ZONE	STAGE	ISSUE DATE
109	A00	CON	2023-12-12

DRAWING NUMBER	REVISION
109-RRR-A00-00-DR-04.00.005	3

AS-BUILT