
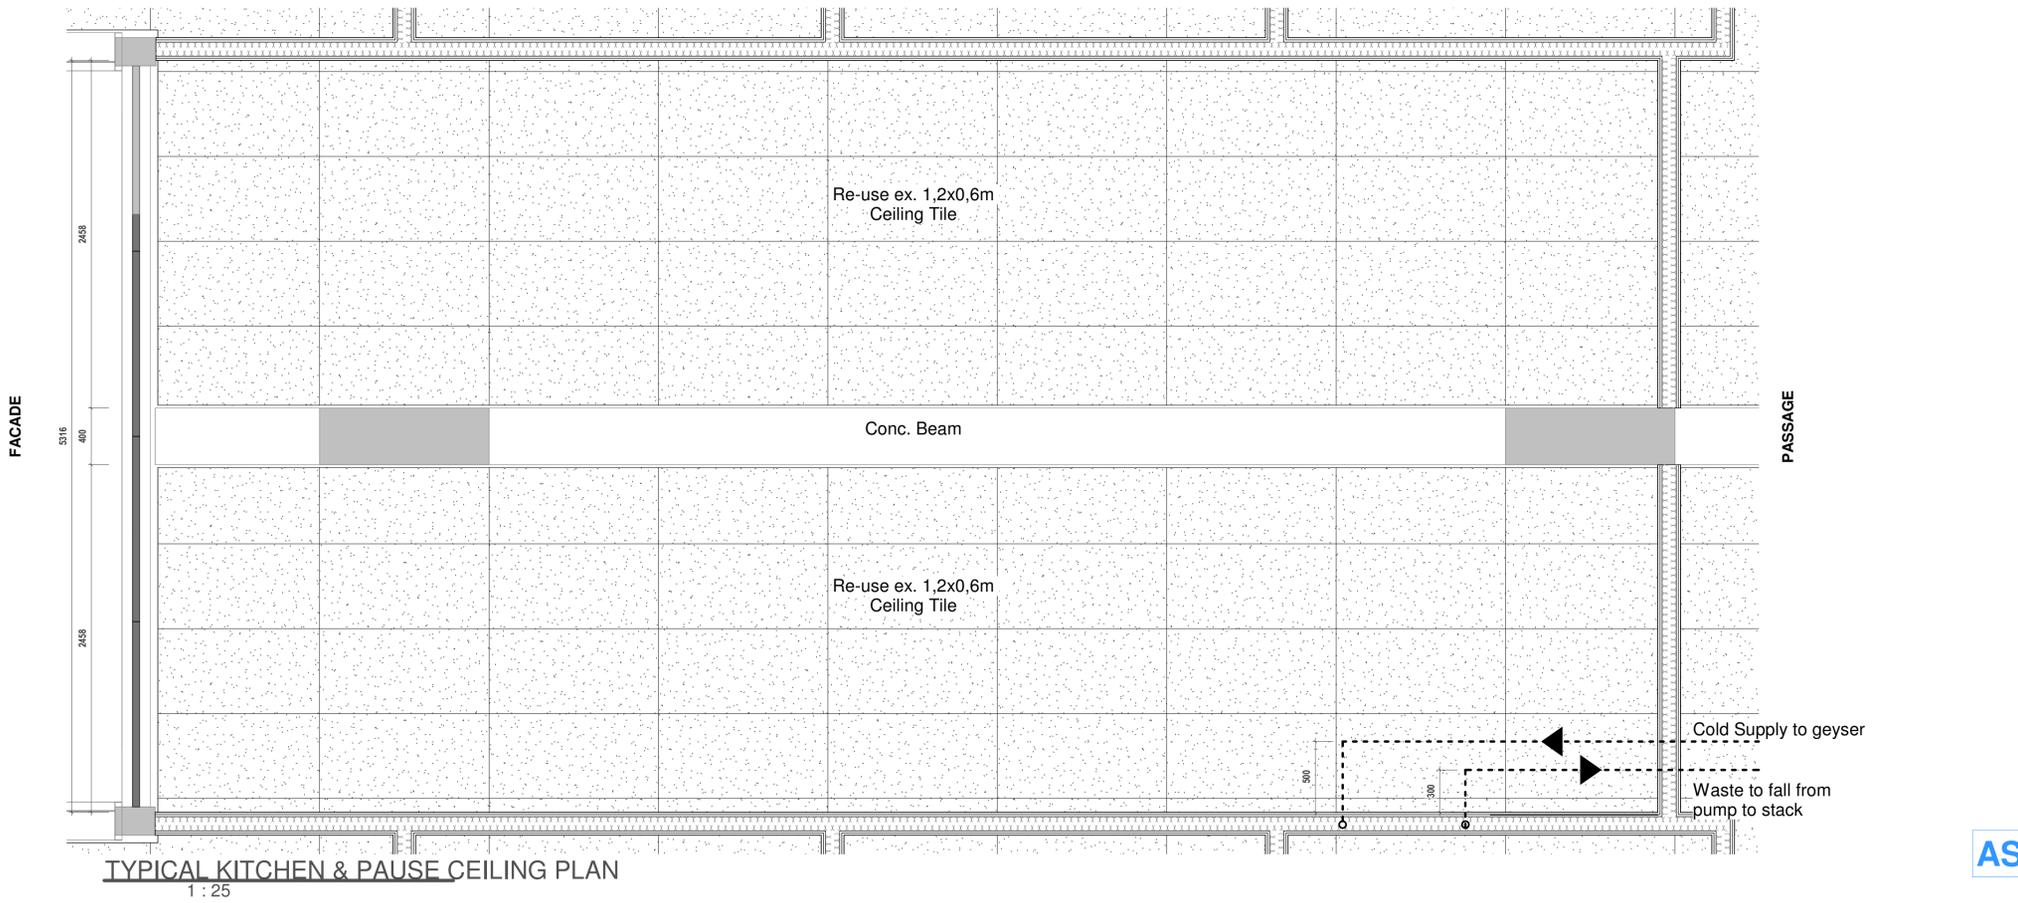


REV	DESCRIPTION	DRAWN	DATE
0	ISSUED FOR CONSTRUCTION		2023.05.30
1	NOGGING ADDED. TYPICAL OFFICE, Elevation A & Layout		2023.07.21

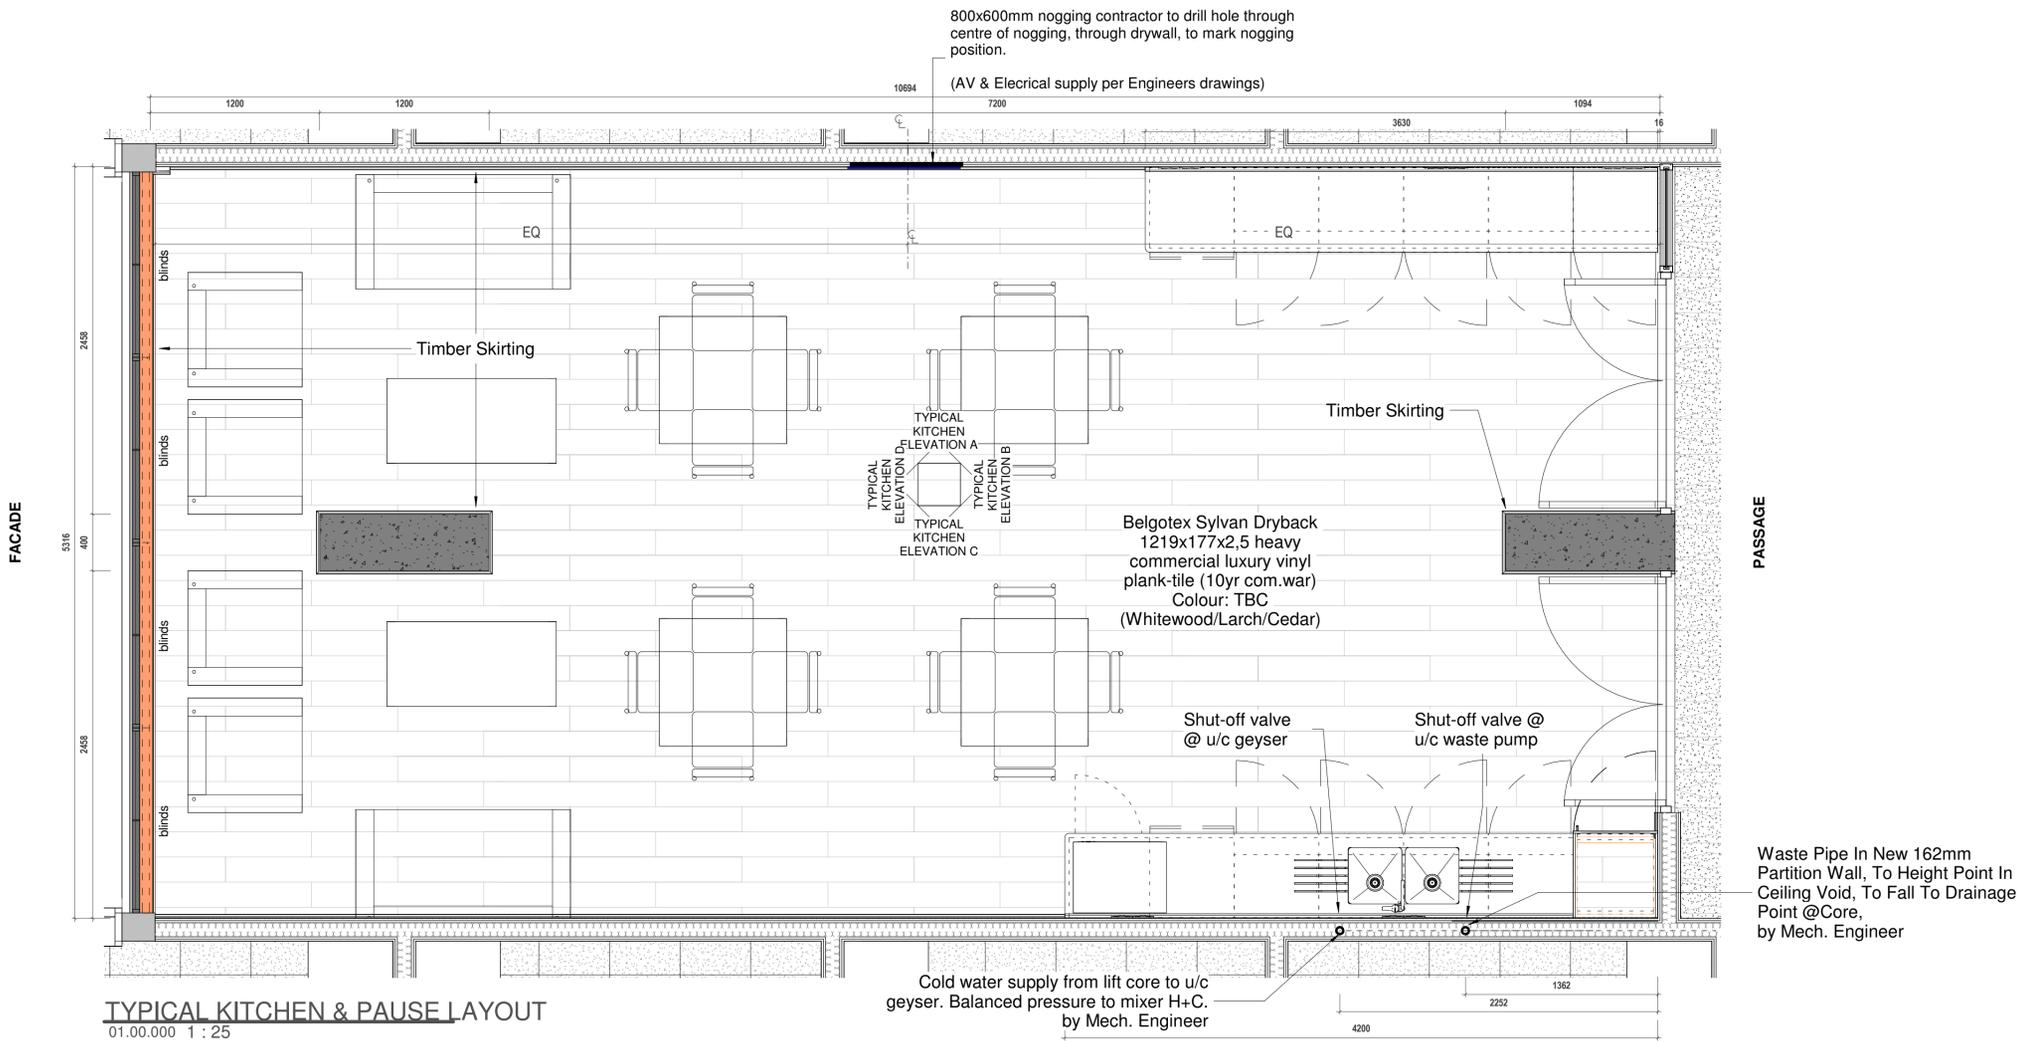

CLIENT:

Building Africa's Prosperity

LEAD CONSULTANT:

ruben reddy architects

Durban | Johannesburg | Cape Town | Bloemfontein | Polokwane  
info@rubenreddyarch.co.za | www.rubenreddyarch.co.za

109\_WP A.3 - Temporary Offices For Members  
4th & 5th Flr\_90 Plein Street

DESIGNED RP	DRAWN JVE	CHECKED RP	APPROVED RP
----------------	--------------	---------------	----------------

TYPICAL KITCHEN PLANS DATA SHEET  
4th&5th FLOORS

TIME STAMP: 2023/12/12 11:11:45		1 : 25 @ A1	
INFORMATION	LA SUBMISSION	TENDER	CONSTRUCTION
PROJECT NUMBER <b>109</b>	ZONE <b>A00</b>	STAGE <b>CON</b>	ISSUE DATE <b>2023.12.12</b>
DRAWING NUMBER <b>109-RRR-A00-XX-DR-04-00.002</b>			REVISION <b>1</b>

**AS-BUILT**