
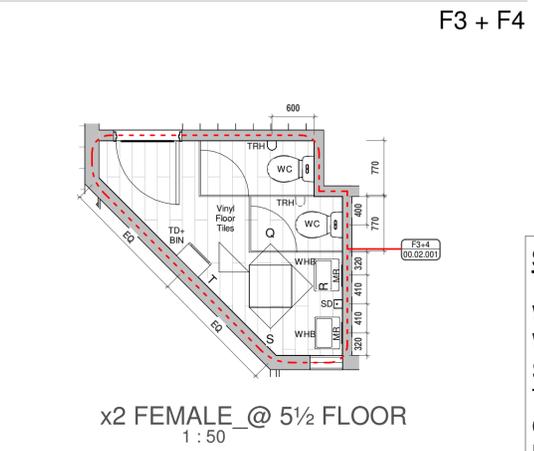
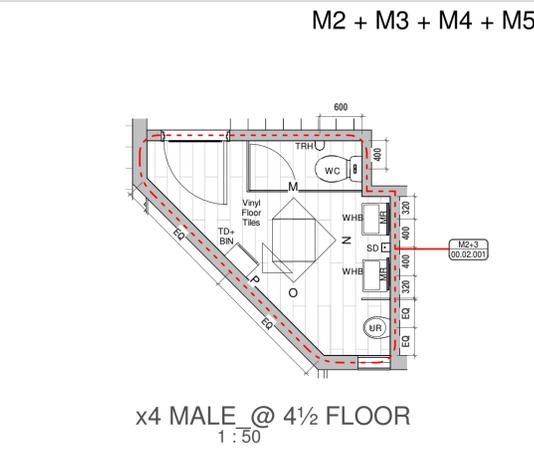
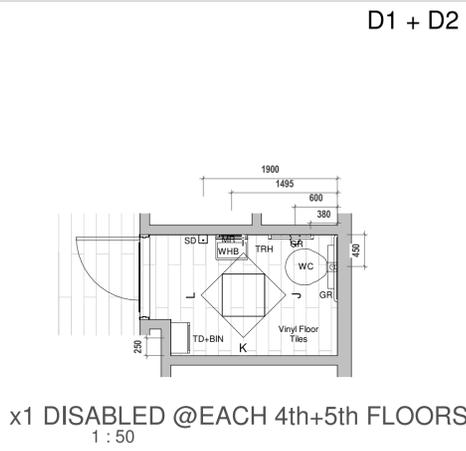
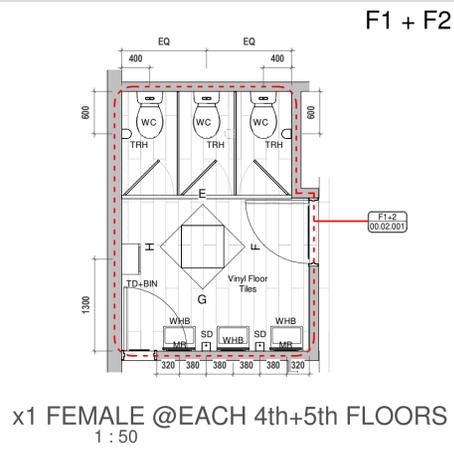


LIFT LOBBY ABLUTIONS

@HALF LANDING BETWEEN 4th+5th FLOORS @HALF LANDING BETWEEN 5th+6th FLOORS

REV	DESCRIPTION	DRAWN	DATE
0	ISSUED FOR CONSTRUCTION		2023.05.30
1	TILING HATCH CORRECTED		2023.05.31



















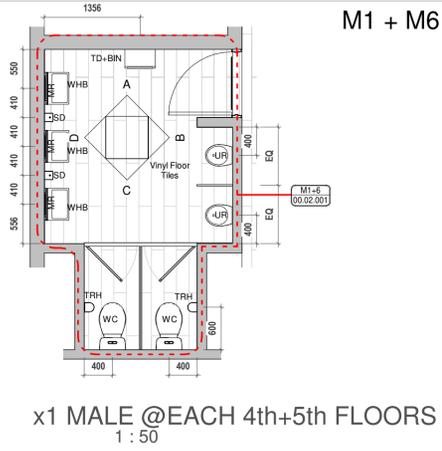


SANITARYWARE LEGEND

- WC = Toilet
- WHB = Wash Hand Basins
- SD = Soap Dispenser
- TD = Towel Dispenser
- GR = Grab Rail
- MR = Mirror
- TRH = Toilet Roll Holder
- BIN = Waste Bin

- Cubicle Partitions
- Vitrex, Vitraflex "Classic"
 - Modular Toilet Cubicles, or Similar Approved

Floor Finish = Vinyl Tiles
Wall Finish = Wall Tiles+ Wall Paper_Type C

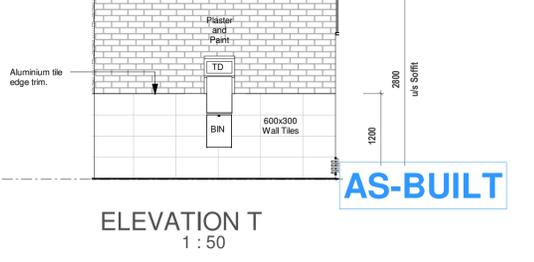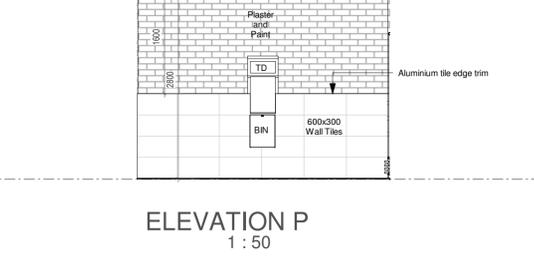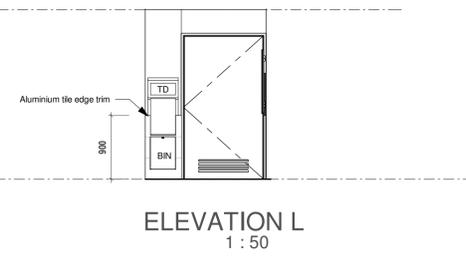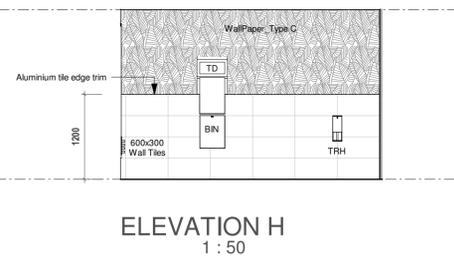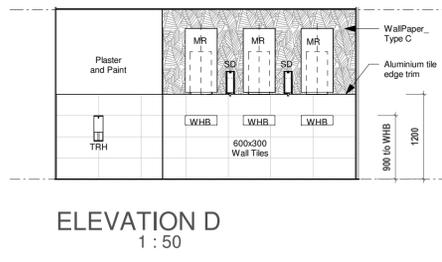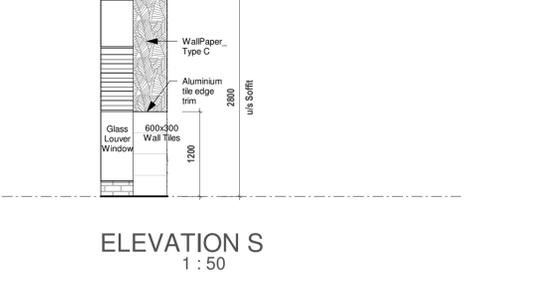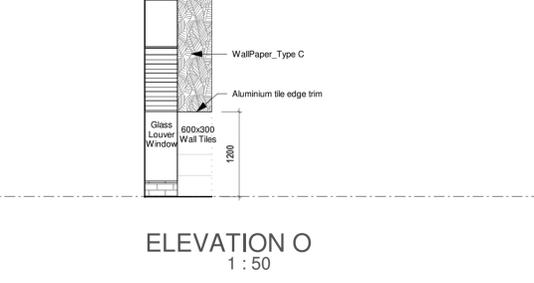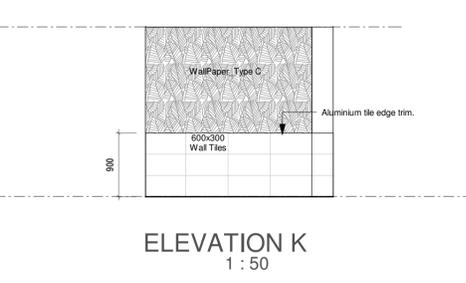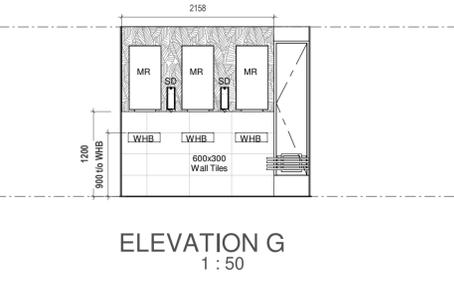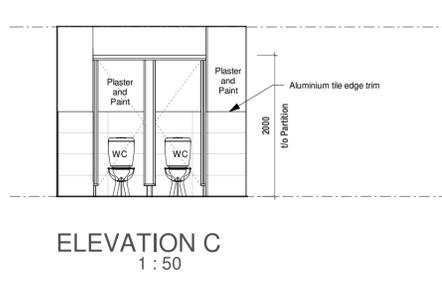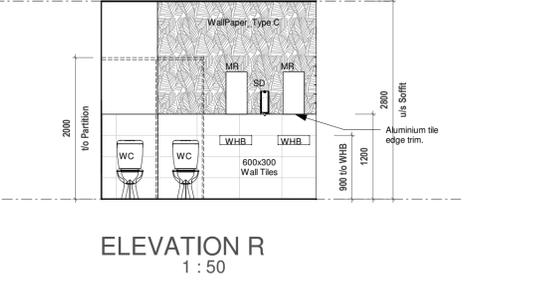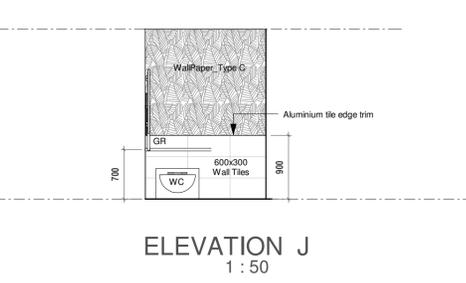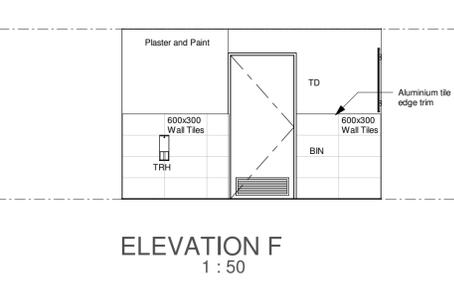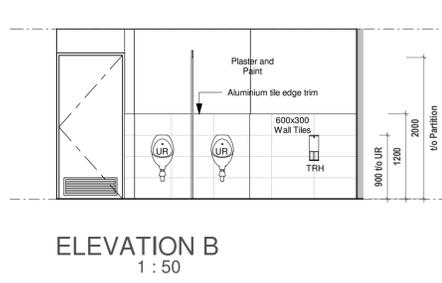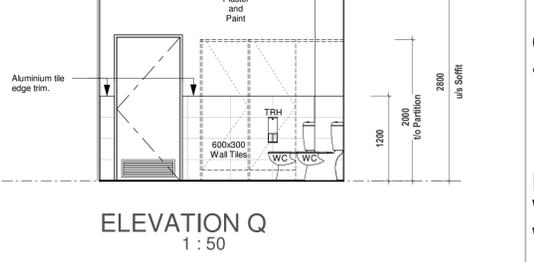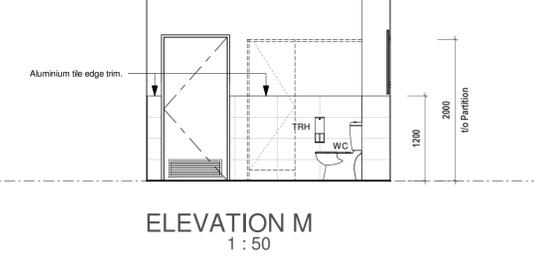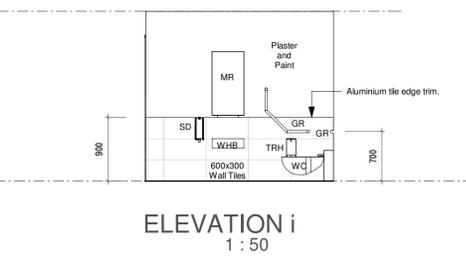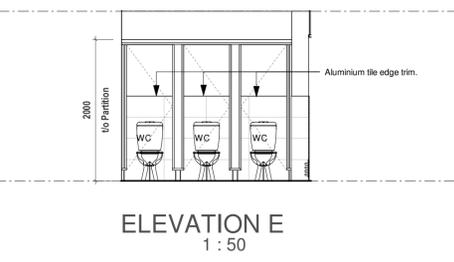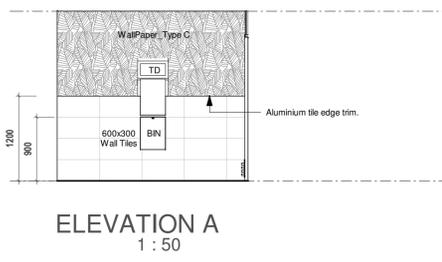

CLIENT:

Building Africa's Prosperity

LEAD CONSULTANT:

Durban | Johannesburg | Cape Town | Bloemfontein | Polokwane
info@rubenreddyarch.co.za | www.rubenreddyarch.co.za

109_WP A.3 - Temporary Offices For Members
4th & 5th Flr_90 Plein Street

DESIGNED RP	DRAWN JNI/JVE	CHECKED RP	APPROVED RP
----------------	------------------	---------------	----------------

ABLUTIONS ROOM DATA
4th&5th FLOORS

TIME STAMP: 2023/12/12 12:01:07	As indicated @ A1		
INFORMATION	LA SUBMISSION	TENDER	CONSTRUCTION
PROJECT NUMBER 109	ZONE A00	STAGE CON	ISSUE DATE 2023.12.12
DRAWING NUMBER 109-RRR-A00-00-DR-04.00.006	REVISION 1		

AS-BUILT