


ISO A1 840mm x 594mm

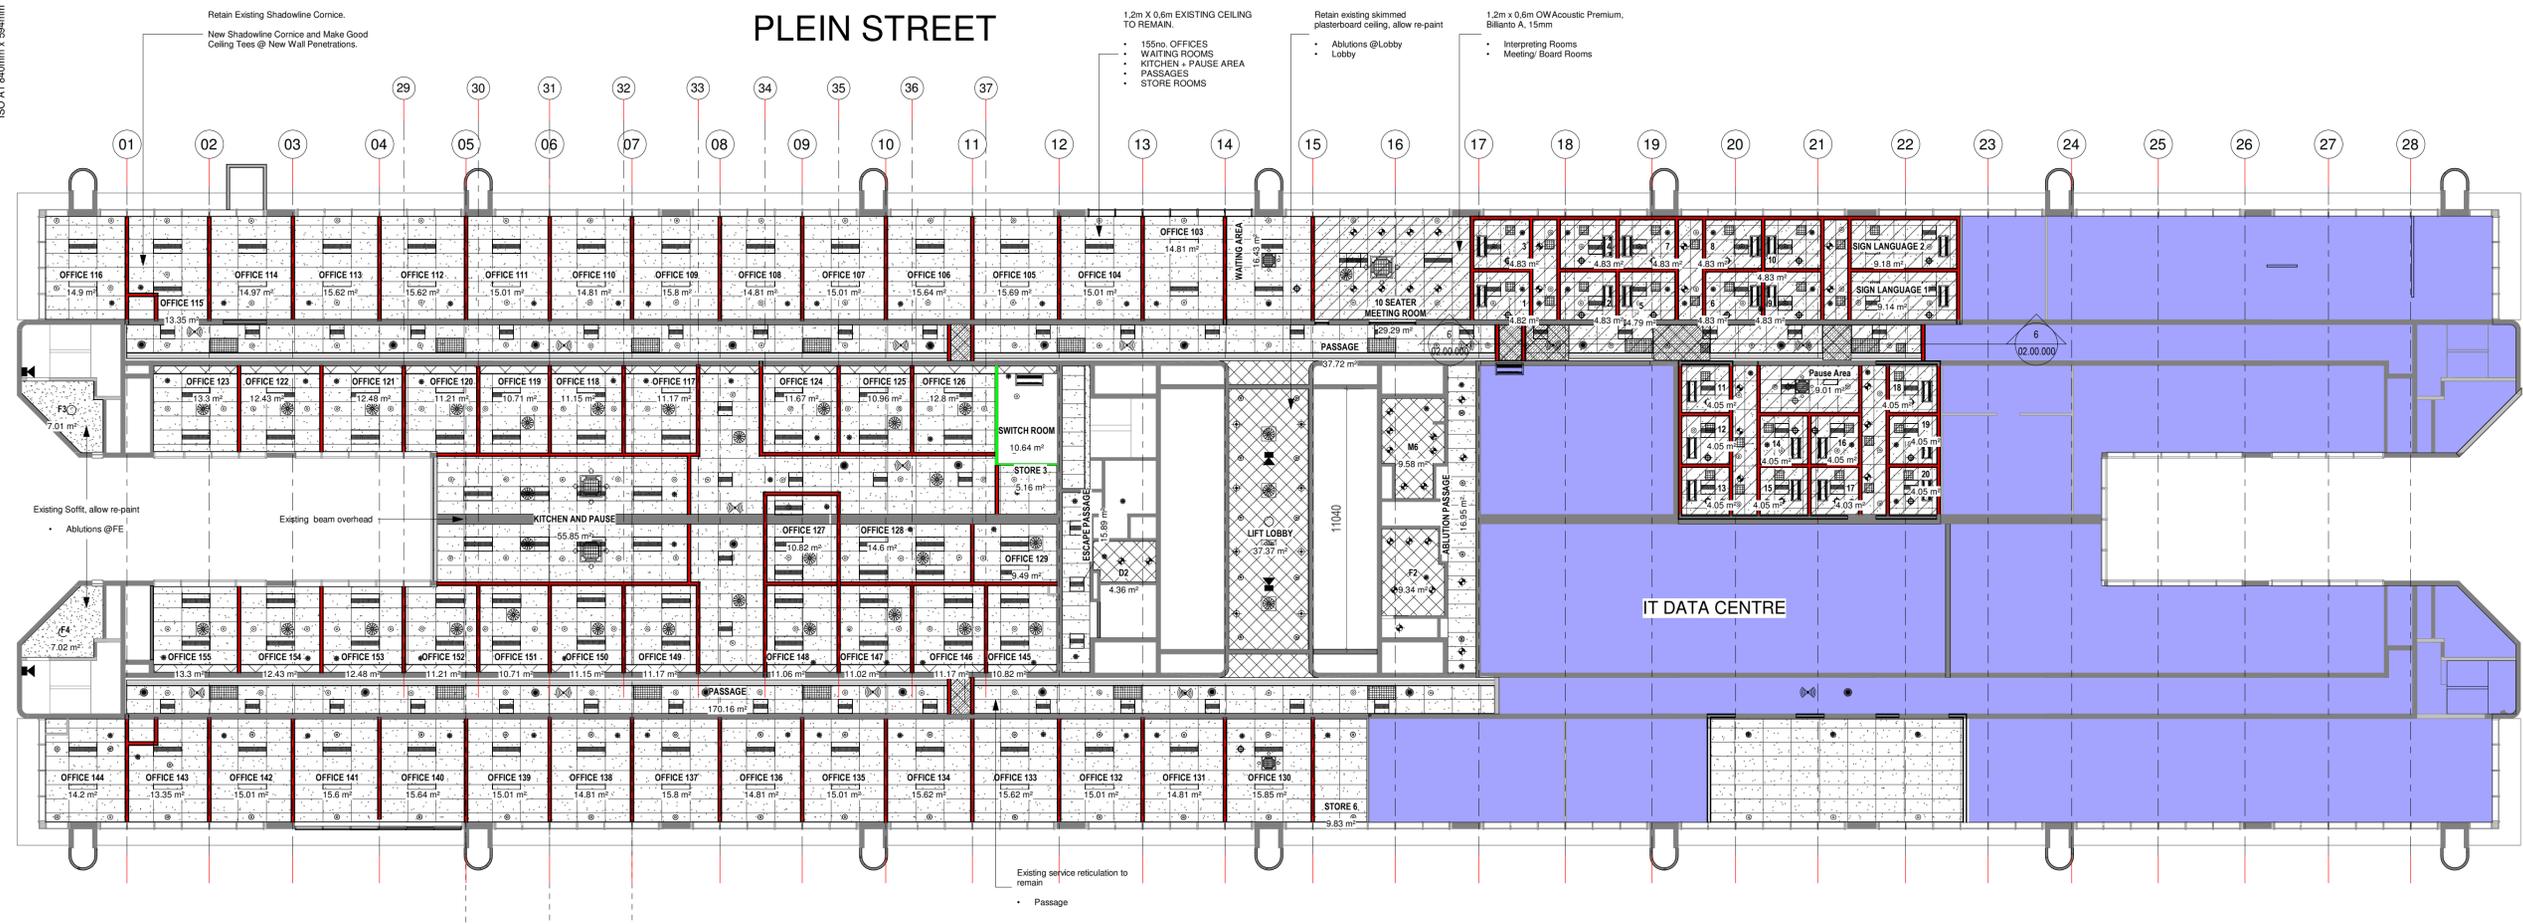


REV	DESCRIPTION	DRAWN	DATE
0	ISSUED FOR CONSTRUCTION		2023.05.30
1	CEILING CO-ORDINATION OF ELEC & MECH		2023.07.22
2	CEILING CO-ORDINATION OF ELEC & MECH. LEGEND UPDATED. MECH UNITS UPDATED IN WAITING ROOMS+10 SEATER MR-SWITCH ROOM, SKIMMED CEILING BULKHEAD ADDED TO PASSAGES		2023.07.27
3	CEILING LAYOUTS, CASSETTE UNITS ADDED TO INTERPRETING ROOMS		2023.08.02
4	CEILING LAYOUTS, REVISED ELEC-MECH UNITS IN 4TH&5TH LIFT LOBBY		2023.08.08
5	CEILING LAYOUT_NOT TO SCALE, Bx A0		2023.08.10

CEILING FINISHES LEGEND

- 1.2m X 0.6m EXISTING CEILING TO REMAIN
- 155no. OFFICES
WAITING ROOMS
KITCHEN + PAUSE AREA
PASSAGES
STORE ROOMS
- 1.2m x 0.6m OW Acoustic Premium, Billianto A, 15mm
- Interpreting Rooms
Meeting Board Rooms
- Retain existing skimmed plasterboard ceiling, allow re-paint
- Abutions @Lobby
Lobby
- Retain Existing Shadowline Cornice,
New Shadowline Cornice and Make Good Ceiling Tees @ New Wall Penetrations.
- Existing Soffit, allow re-paint
Abutions @FE
- New Skimmed Bulkhead Ceiling
Passages

5th FLOOR
NOT TO SCALE

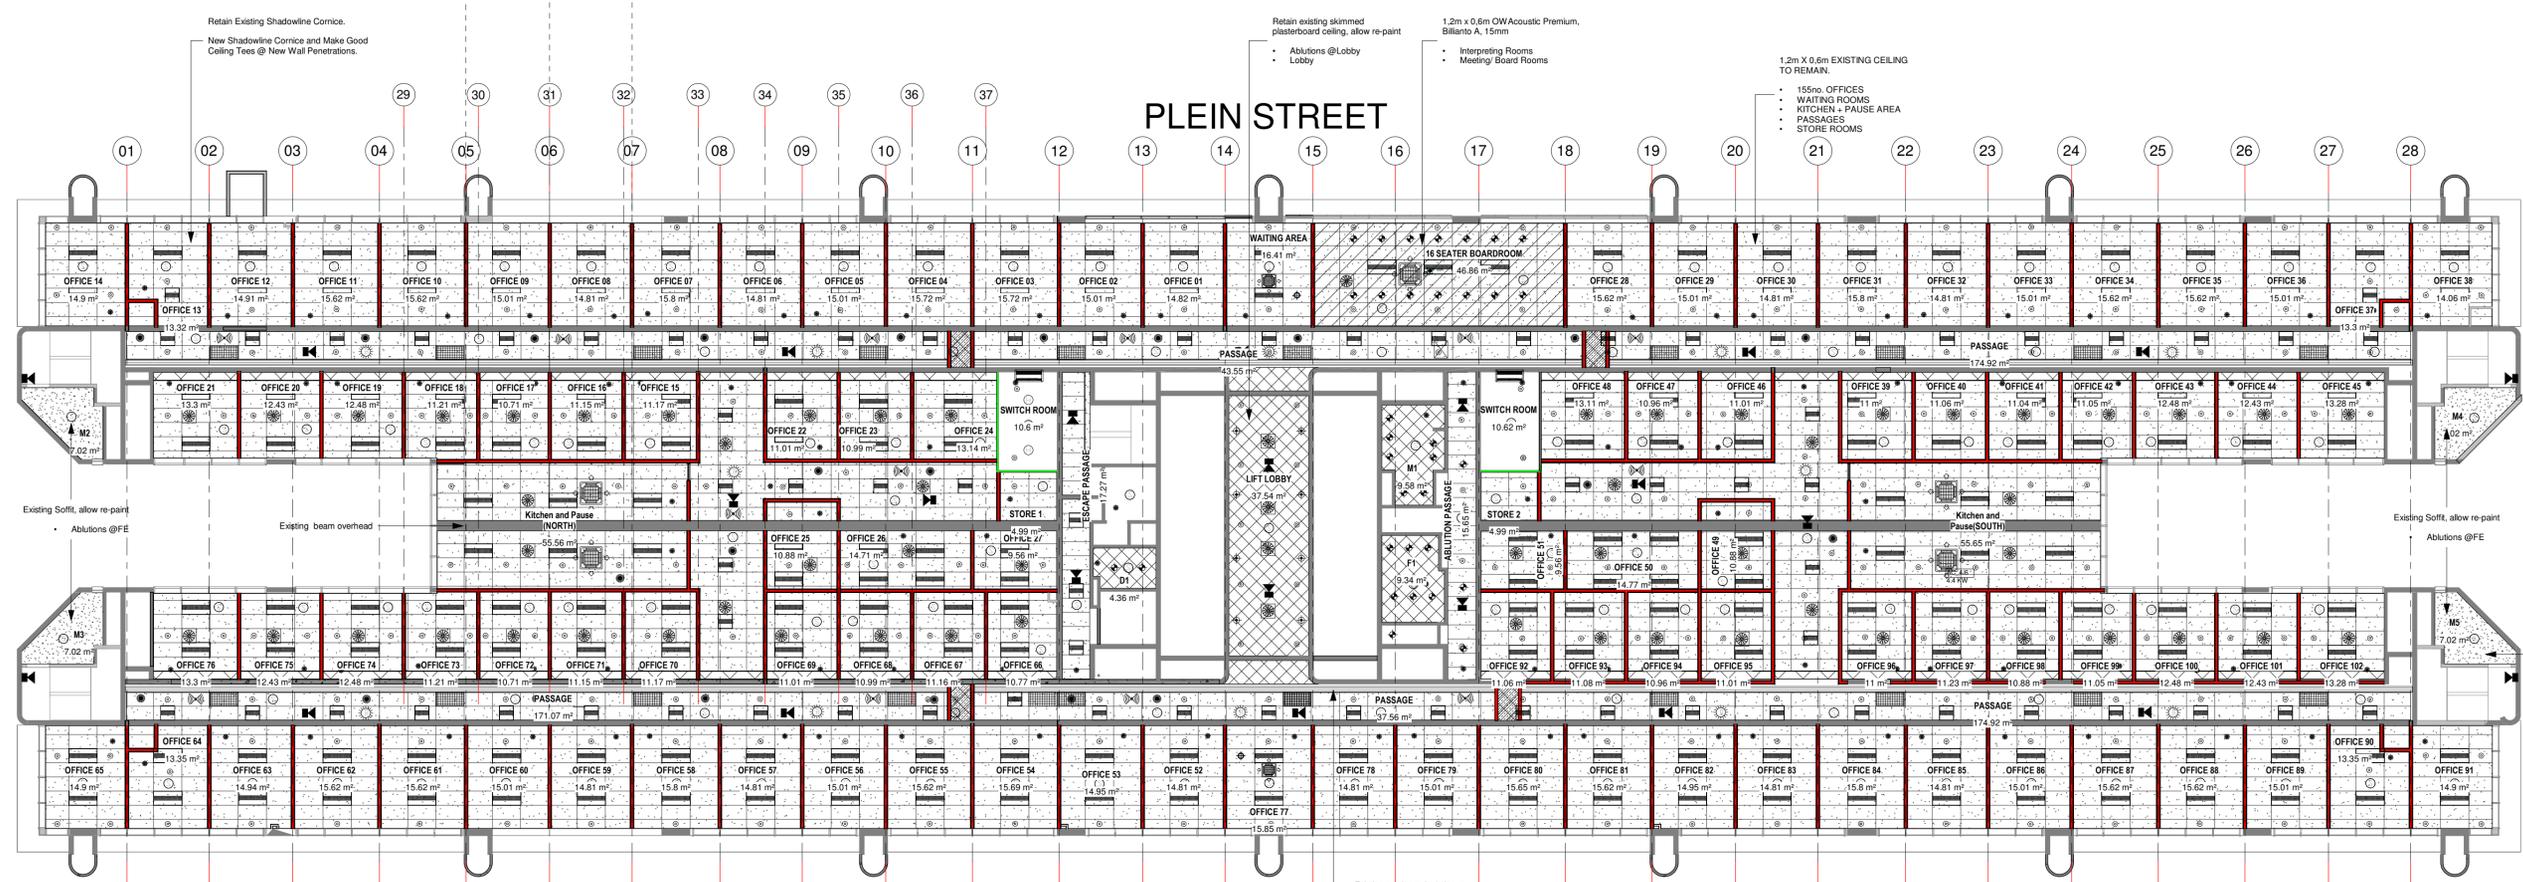

CLIENT:

DBSA
DEVELOPMENT BANK OF SOUTHERN AFRICA
Building Africa's Prosperity

LEAD CONSULTANT:

DURAPI CONSULTING

ruben reddy architects
Durban | Johannesburg | Cape Town | Bloemfontein | Polokwane
info@rubenreddy.co.za | www.rubenreddy.co.za

109_WP A.3 - Temporary Offices For Members
Existing Soffit, allow re-paint
Abutions @4th & 5th Flr_90 Plein Street

DESIGNED RP	DRAWN RJ/JVE	CHECKED RP	APPROVED RP
----------------	-----------------	---------------	----------------

EXISTING+PROPOSED CEILING LAYOUTS
4TH & 5TH FLOORS

TIME STAMP: 2023/12/12 10:40:02	As indicated @ A1		
INFORMATION	LA SUBMISSION	TENDER	CONSTRUCTION
PROJECT NUMBER 109	ZONE A00	STAGE CON	ISSUE DATE 2023-12-12
DRAWING NUMBER 109-RRR-A00-00-DR-01.02.000	REVISION 5		

4TH FLOOR
1:150

NOT TO SCALE

AS-BUILT

PROJECT NO. ORG. | ZONE | LEVEL | TYPE | ISS | SHEET NO.
Copyright © 2023 by Ruben Reddy Architects. All Rights Reserved.
 Autodesk Revit 2023, AutoCAD 2023, Microsoft Office 365, Adobe Photoshop 2023, Adobe Illustrator 2023