

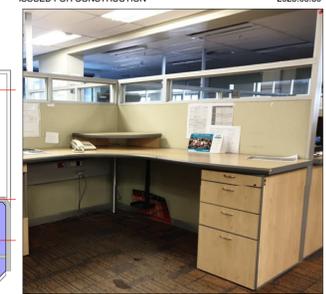


REV	DESCRIPTION	DRAWN	DATE
0	ISSUED FOR CONSTRUCTION		2023.05.30

# PLEIN STREET

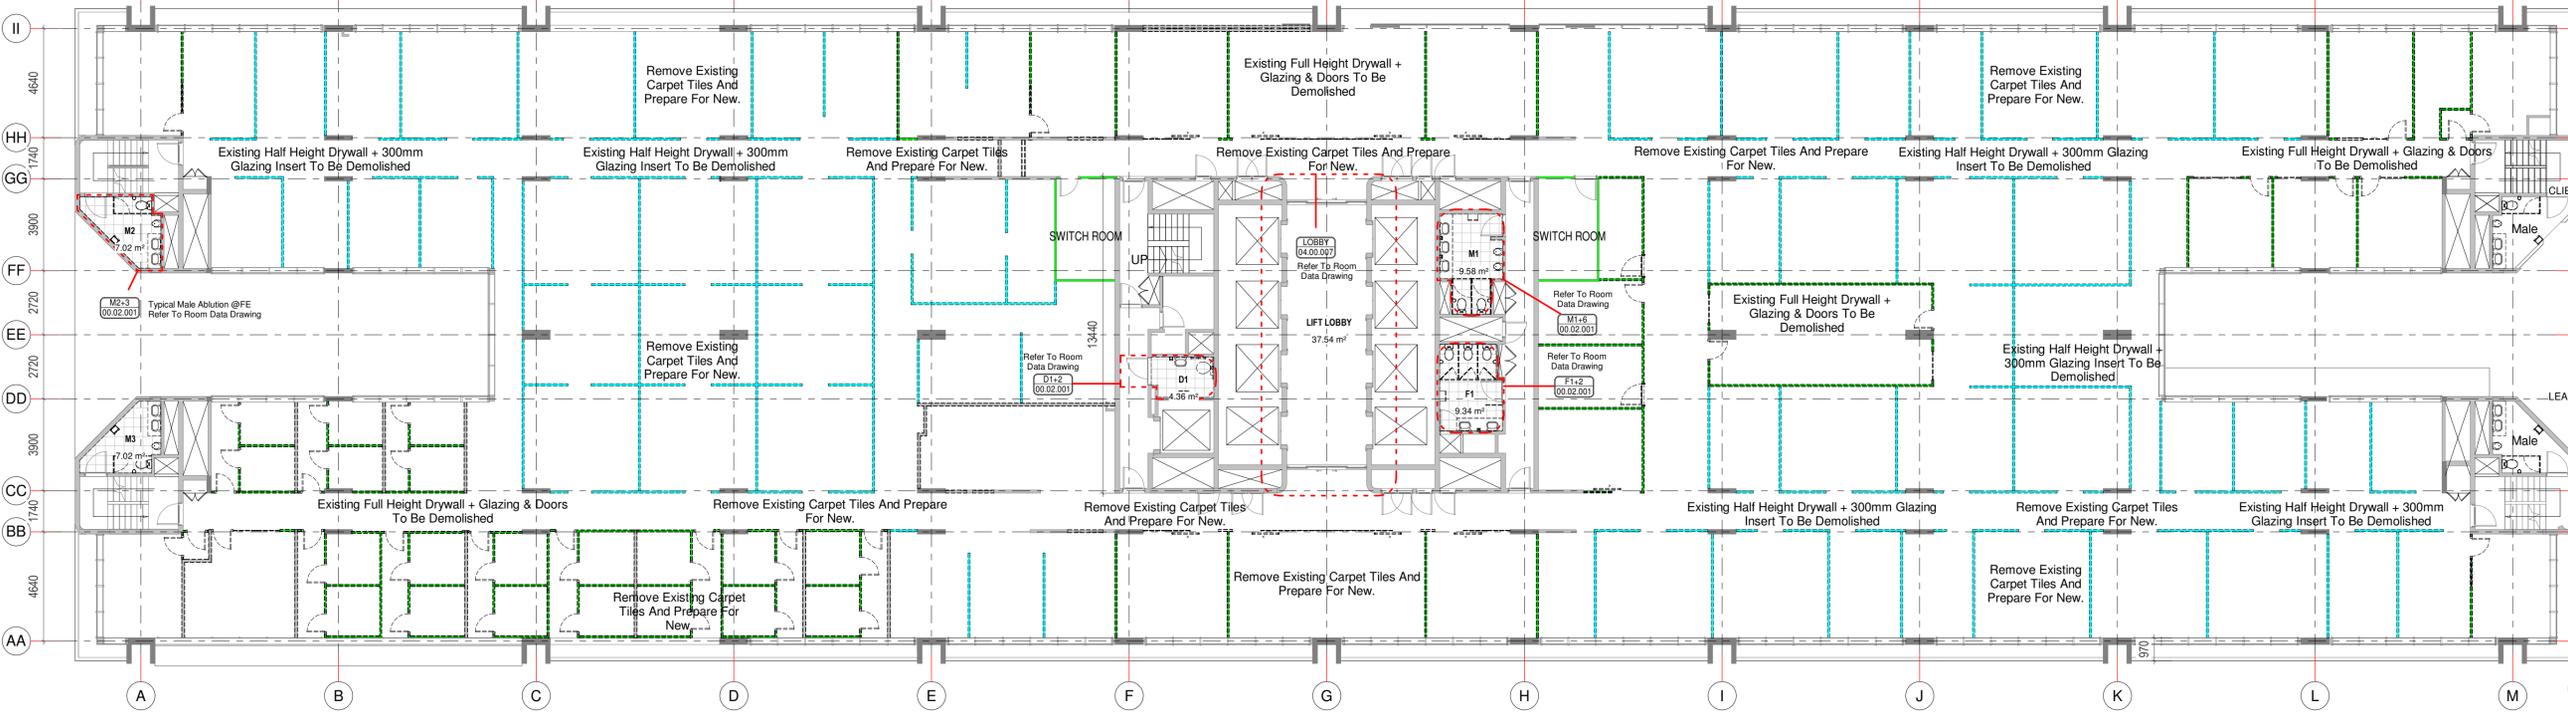

- Existing 600x1200 Lay-In Ceiling to Remain
- Remove Existing Glass Panels + Aluminium Frame
- Remove Existing Gypsum Partition
- Remove Existing Carpet Tiles.

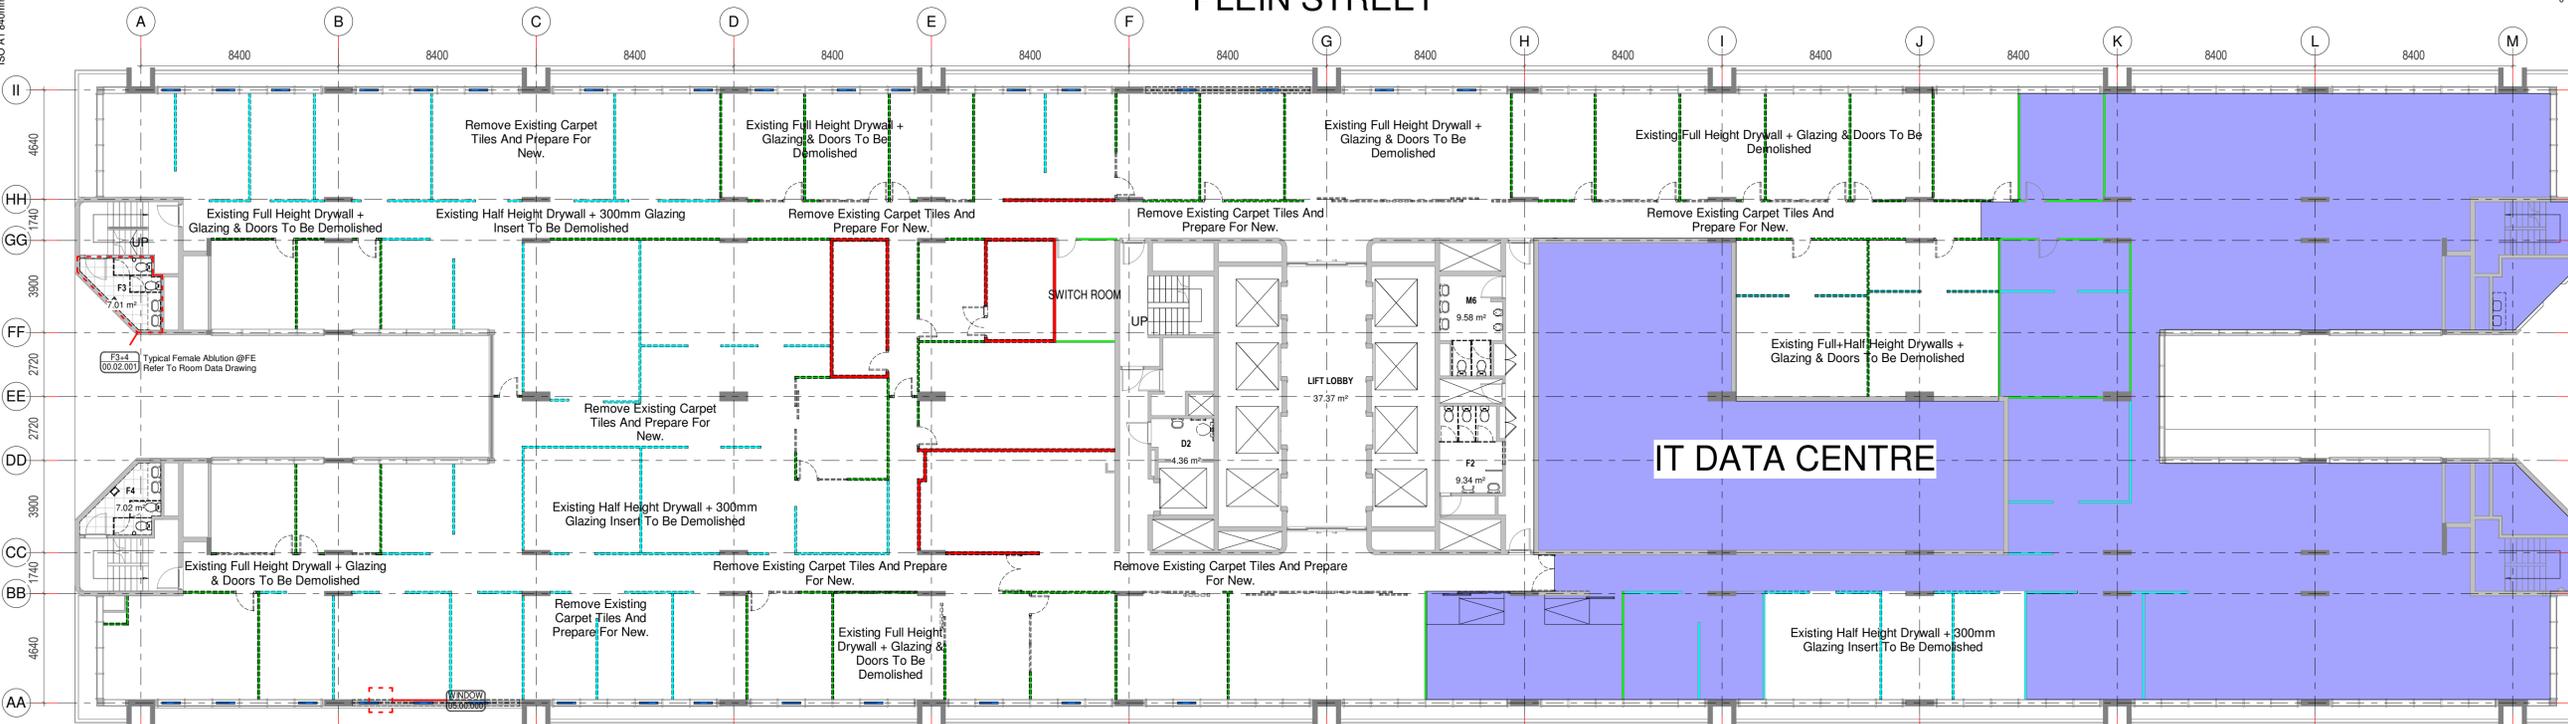

- Remove Existing Power Skirting And Store For Refitting



- Remove Glazed Partitions + Doors

**DBSA**  
DEVELOPMENT BANK OF SOUTHERN AFRICA  
Building Africa's Prosperity  
LEAD CONSULTANT:



**DUFARI**  
CONSULTING

ruben reddy architects  
Durban | Johannesburg | Cape Town | Bloemfontein | Polokwane  
info@rubenreddyarch.co.za | www.rubenreddyarch.co.za

109\_WP A.3 - Temporary Offices For Members  
4th & 5th Flr\_90 Plein Street

DESIGNED	DRAWN	CHECKED	APPROVED
RP	RJ/JN	RP	RP

## DEMOLITION WORKS 4TH & 5TH FLOOR LAYOUTS

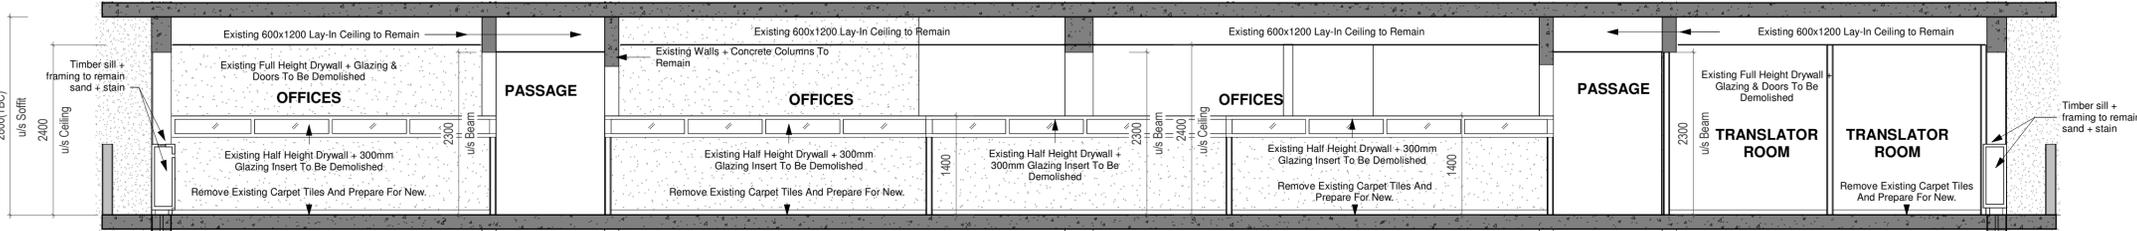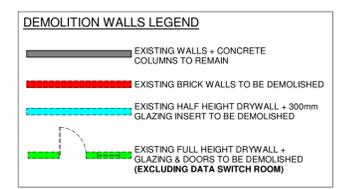

TIME STAMP:	2023/12/19 12:32:29	As indicated @ A1
INFORMATION	LA SUBMISSION	CONSTR CONSTRUCTION
PROJECT NUMBER	109	ISSUE DATE
ZONE	A00	2023-12-12
STAGE	DD	
DRAWING NUMBER	109-RRA-A00-00-DR-00.02.000	REVISION
		0

**AS-BUILT**