


5th FLOOR
 02.00.000 1 : 150

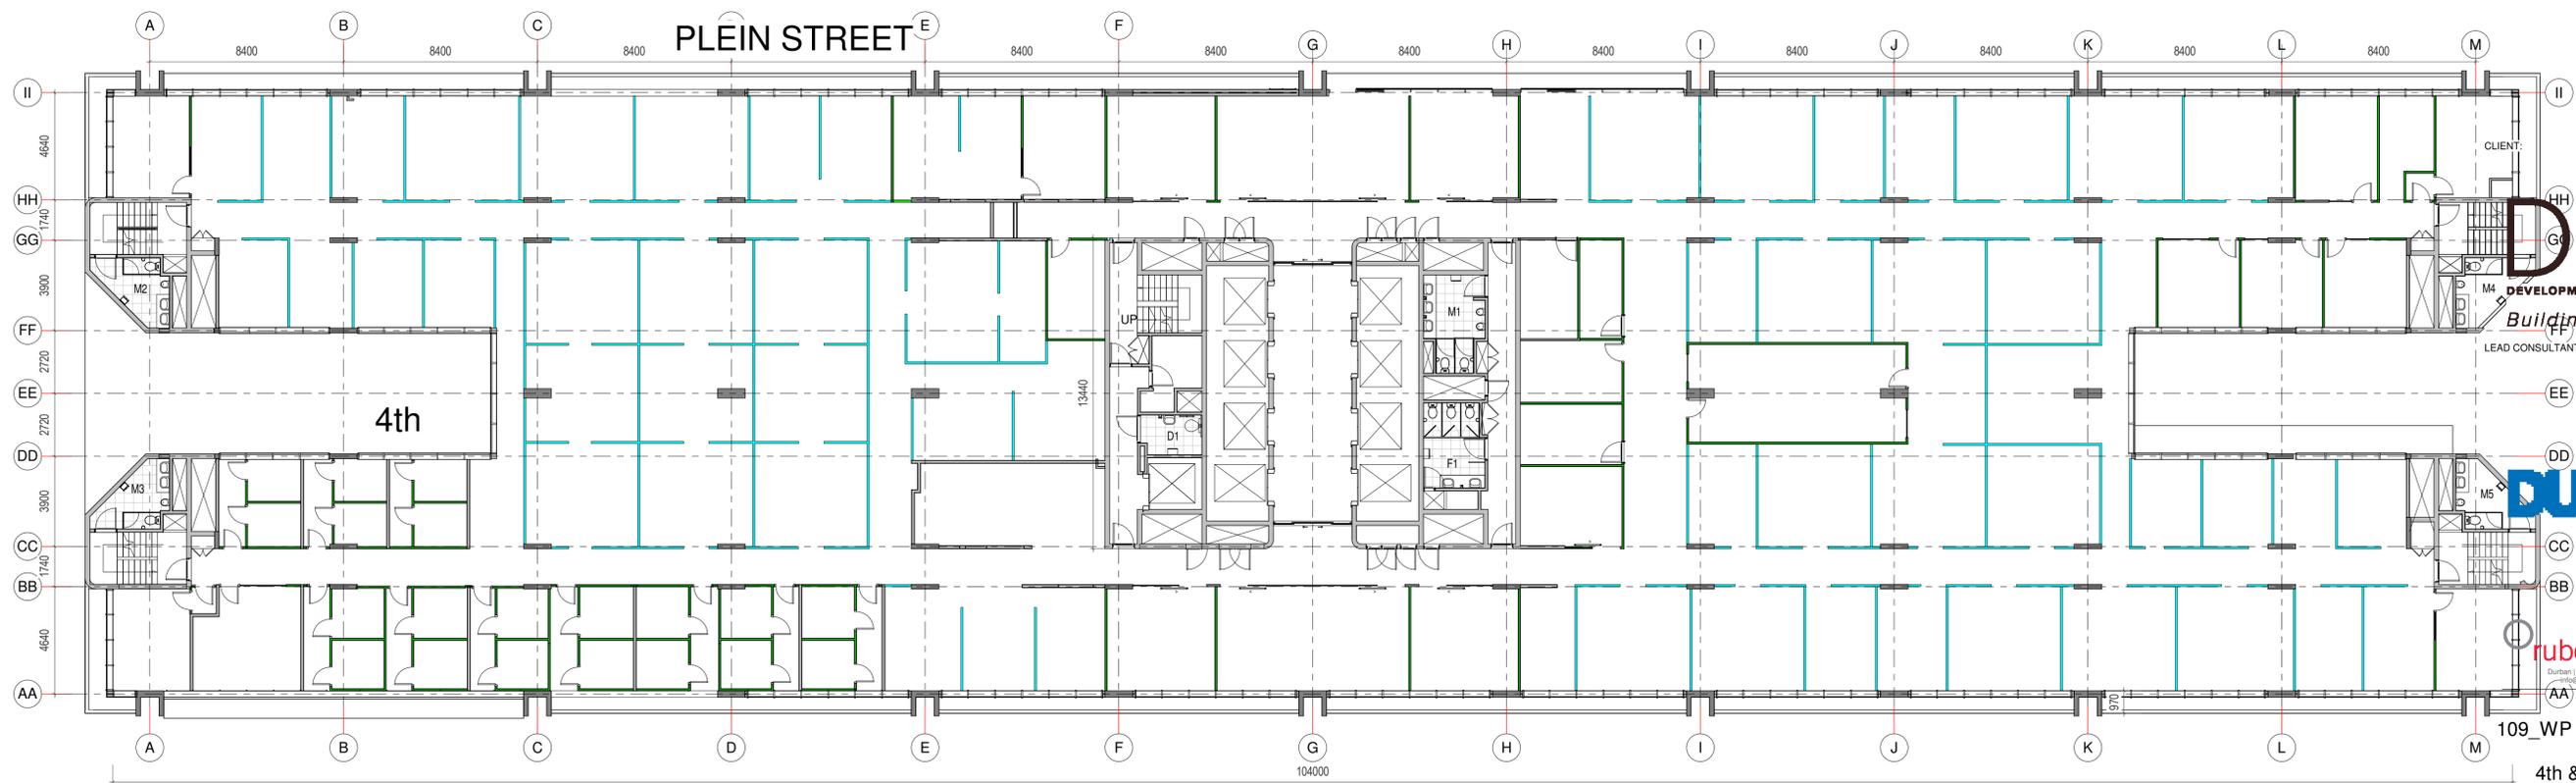

4th FLOOR
 02.00.000 1 : 150

DBSA
 DEVELOPMENT BANK OF SOUTHERN AFRICA
Building Africa's Prosperity
 LEAD CONSULTANT:

DURAPI
 CONSULTING

ruben reddy architects
 Durban | Johannesburg | Cape Town | Bloemfontein | Polokwane
 info@rubenreddyarch.co.za | www.rubenreddyarch.co.za

109_WP A.3 - Temporary Offices For Members
 4th & 5th Flr_90 Plein Street

EXISTING WALLS LEGEND

- EXISTING WALLS + CONCRETE COLUMNS
- EXISTING BRICK WALLS
- EXISTING HALF HEIGHT DRYWALL + 300mm GLAZING INSERT
- EXISTING FULL HEIGHT DRYWALL + GLAZING & DOORS

DESIGNED RP	DRAWN JN/RJ	CHECKED RP	APPROVED RP
----------------	----------------	---------------	----------------

**EXISTING LAYOUTS
 4TH & 5TH FLOORS**

AS-BUILT

TIME STAMP: 2023/12/19 12:17:26 As indicated @ A1

INFORMATION	LA SUBMISSION	TENDER	CONSTRUCTION
PROJECT NUMBER 109	ZONE A00	STAGE CON	ISSUE DATE 2023-12-12
DRAWING NUMBER 109-RR-A00-00-DR-00.00.000			REVISION 0