



ELEVATION A  
04.00.008 1 : 20



ELEVATION B  
04.00.004 1 : 20

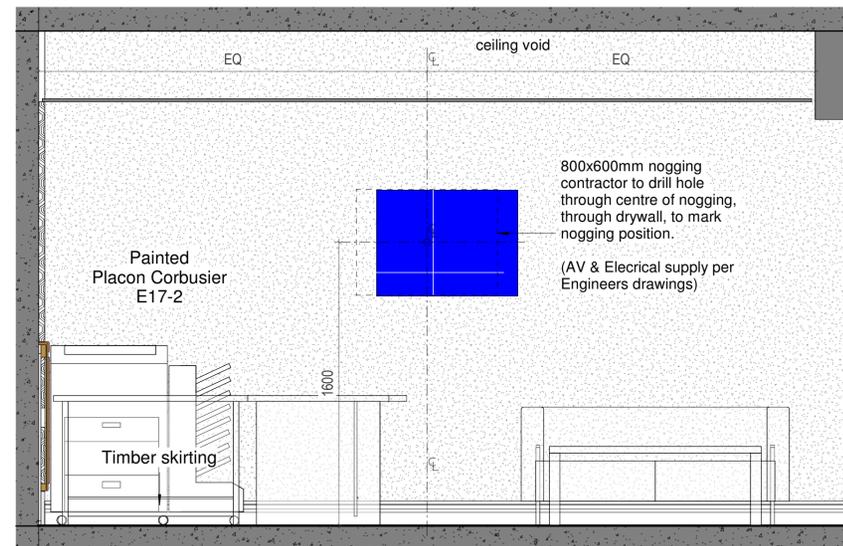

ELEVATION C  
04.00.008 1 : 20

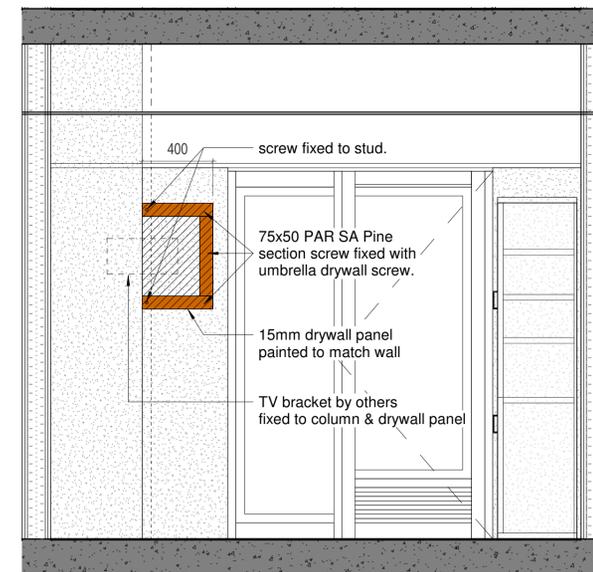

ELEVATION D  
1 : 20

CLIENT:

**DBSA**  
DEVELOPMENT BANK OF SOUTHERN AFRICA  
*Building Africa's Prosperity*

LEAD CONSULTANT:

**DURAPI**  
CONSULTING

**ruben reddy architects**  
Durban | Johannesburg | Cape Town | Bloemfontein | Polokwane  
info@rubenreddyarch.co.za | www.rubenreddyarch.co.za

109\_WP A.3 - Temporary Offices For Members  
4th & 5th Flr\_90 Plein Street

DESIGNED	DRAWN	CHECKED	APPROVED
RP	JNI/JVE	RP	RP

WAITING AREA  
4th & 5th FLOORS

AS-BUILT

TIME STAMP: 2023/12/12 12:14:57 1 : 20 @ A1

INFORMATION	LA SUBMISSION	TENDER	CONSTRUCTION
PROJECT NUMBER	ZONE	STAGE	ISSUE DATE
109	A00	DD	2023.12.12
DRAWING NUMBER			REVISION
109-RRR-A00-00-DR-04.00.008			1
PROJECT NO.	ORIG.	ZONE	LEVEL