

GENERAL NOTES

THIS DRAWING IS TO BE READ IN CONJUNCTION WITH ALL RELEVANT ARCHITECT'S AND ENGINEER'S DRAWING.

ALL DIMENSIONS, LEVELS, ETC. ARE TO BE CHECKED BEFORE ANY WORK IS COMMENCED AND ANY DISCREPANCIES NOTED TO BE BROUGHT TO THE ARCHITECT'S ATTENTION.

ONLY FIGURED DIMENSIONS TO BE USED. SCALING OF DRAWINGS IS NOT ADVISABLE.

ALL RIGHTS RESERVED. NO PARTS OF THIS DESIGN SHALL BE REPRODUCED, USED ELSEWHERE AND/ OR IN ANY WAY WITHOUT PRIOR PERMISSION FROM THE ARCHITECT/ ENGINEER.

GEOTECH INFORMATION		
SOIL TYPE:		
ASSUMED SOIL BEARING CAPACITY: _____ kPa		
RECOMMENDED FOUNDATION TYPE:		
RECOMMENDED FOUNDATION DEPTH:		
REV No.	DATE	DESCRIPTION
3	21-07-21	GIRLS ABLUTION ADDED

MUNICIPAL APPROVAL

NAME:

SIGNATURE:DATE:

STAMPS:

CLIENT APPROVALS

North West Department of Education:

NAME: SIGNATURE: DATE:

DBSA Architect:

NAME: SIGNATURE: DATE:


DBSA OH&S:

NAME: SIGNATURE: DATE:

PRINCIPAL AGENT

KITSO BOTHLHALE
CONSULTING ENGINEERS & ARCHITECTS
Tel +27(0)12 663 1357 - Cell +27 (0) 82 903 8497 - Fax +27(0)12 663 3351
E-mail: ktsa@kitsobothale.co.za Website: www.kitsobothale.co.za
Unit 2 International Business Gateway, 18 Midridge Park, C/o Pioneer Avenue & Elizabeth Road, Extension 5 Midridge Park, Midrand, 1682

COMPETENT CONTACT PERSON:	CONTACT No: +27 (0)12 663 1357
Bruce Mutarwa	FIRM REG No: T.B.C.

 **education**
Lefapha la Thuto
Onderwys Departement
Department of Education
NORTH WEST PROVINCE

DEPARTMENT OF BASIC EDUCATION
222 STRUBEN STREET
PRETORIA

DISCIPLINE

ARCHITECTURAL

PROJECT NAME

Tshedimoso Primary School

PORTION 1 OF THE FARM MOOIPAN No. 104 - IO
MEASURING - 33 479 m²

PROJECT STATUS		
STAGE 1-3	STAGE 4	STAGE 5-6
CONCEPT	X TENDER	CONSTRUCTION

DESCRIPTION

MEDIA CENTRE
(BLOCK 3)
SECTION & ROOF PLAN

SCALE:
AS SHOWN

DRAWN:

NAME OF COMPETENT PERSON: **M.L. van der Walt**

CHECKED:

NAME OF COMPETENT PERSON: **A.A. Steyn**

REG No: **Pr.Arch. 7292**

SIGNATURE

REG No: **Pr.Arch. 20832**

SIGNATURE

PROJECT NUMBER

S-TSH-001-30


OCCUPANCY CLASSIFICATION

A3


DATE:
01-11-2021

DWG No:
103/3

REV No:
04

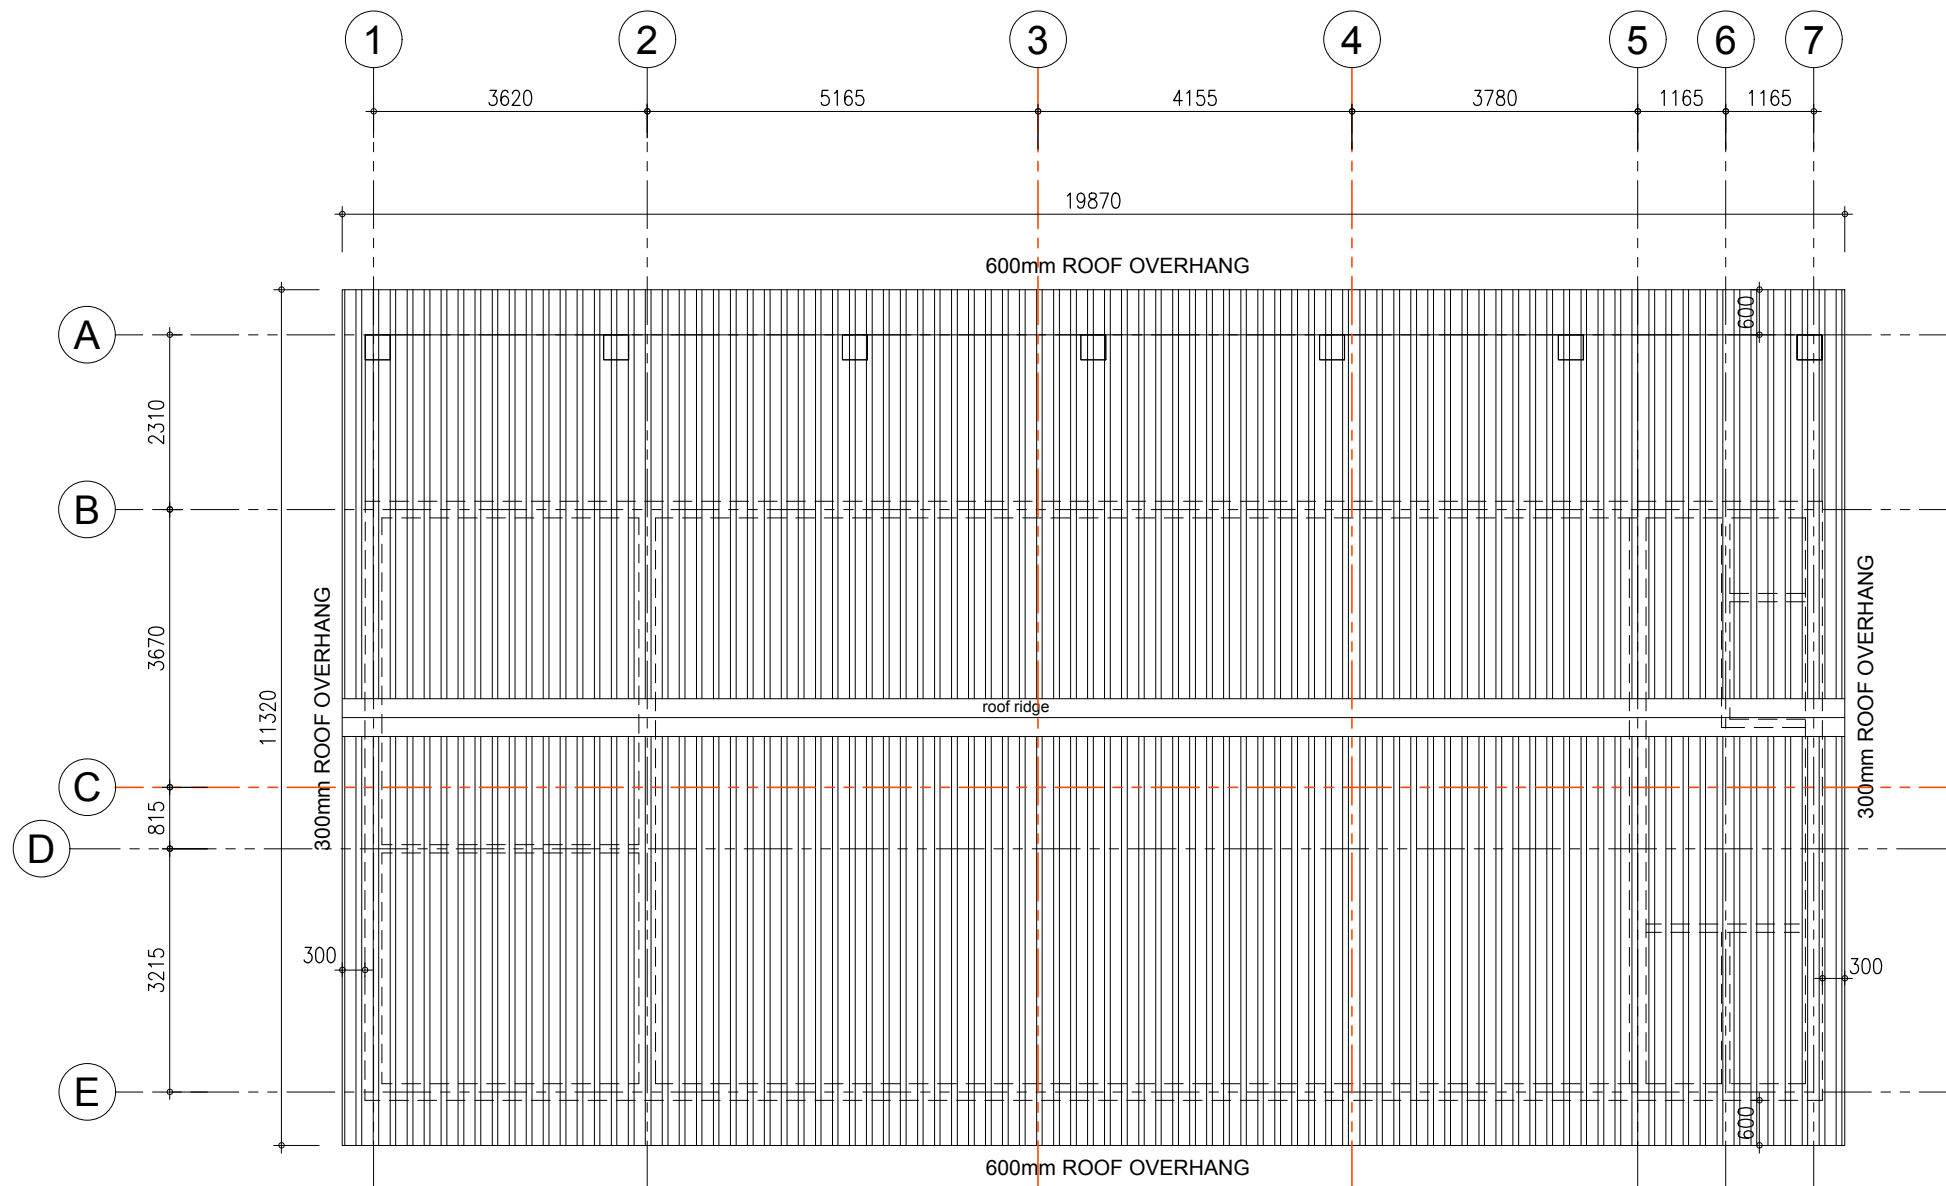

Roof plan
Scale 1:100

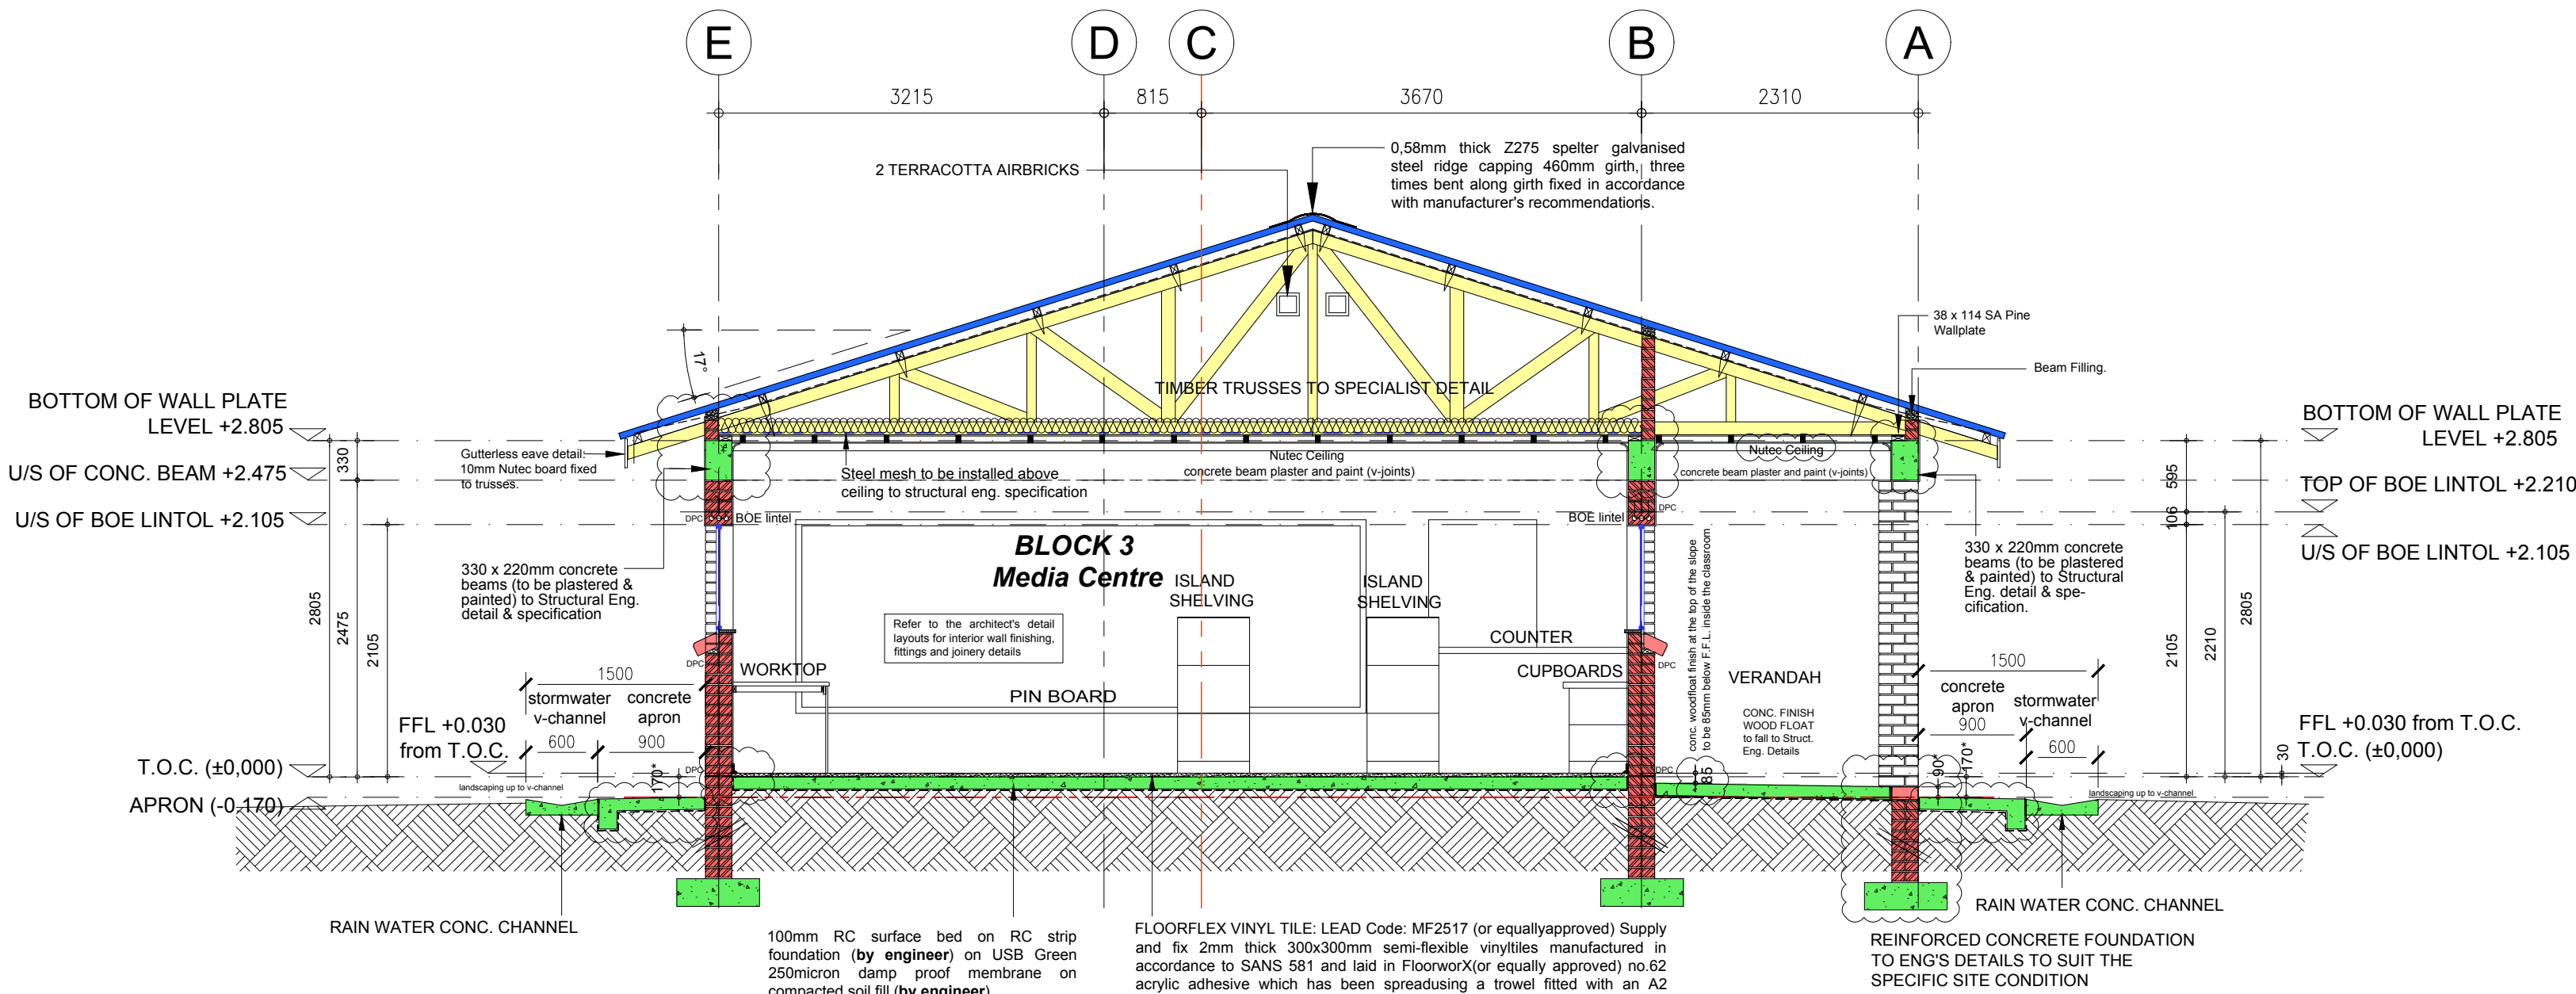

Section A-A
Scale 1 : 50

