


INLET WORKS

DEGRITTERS

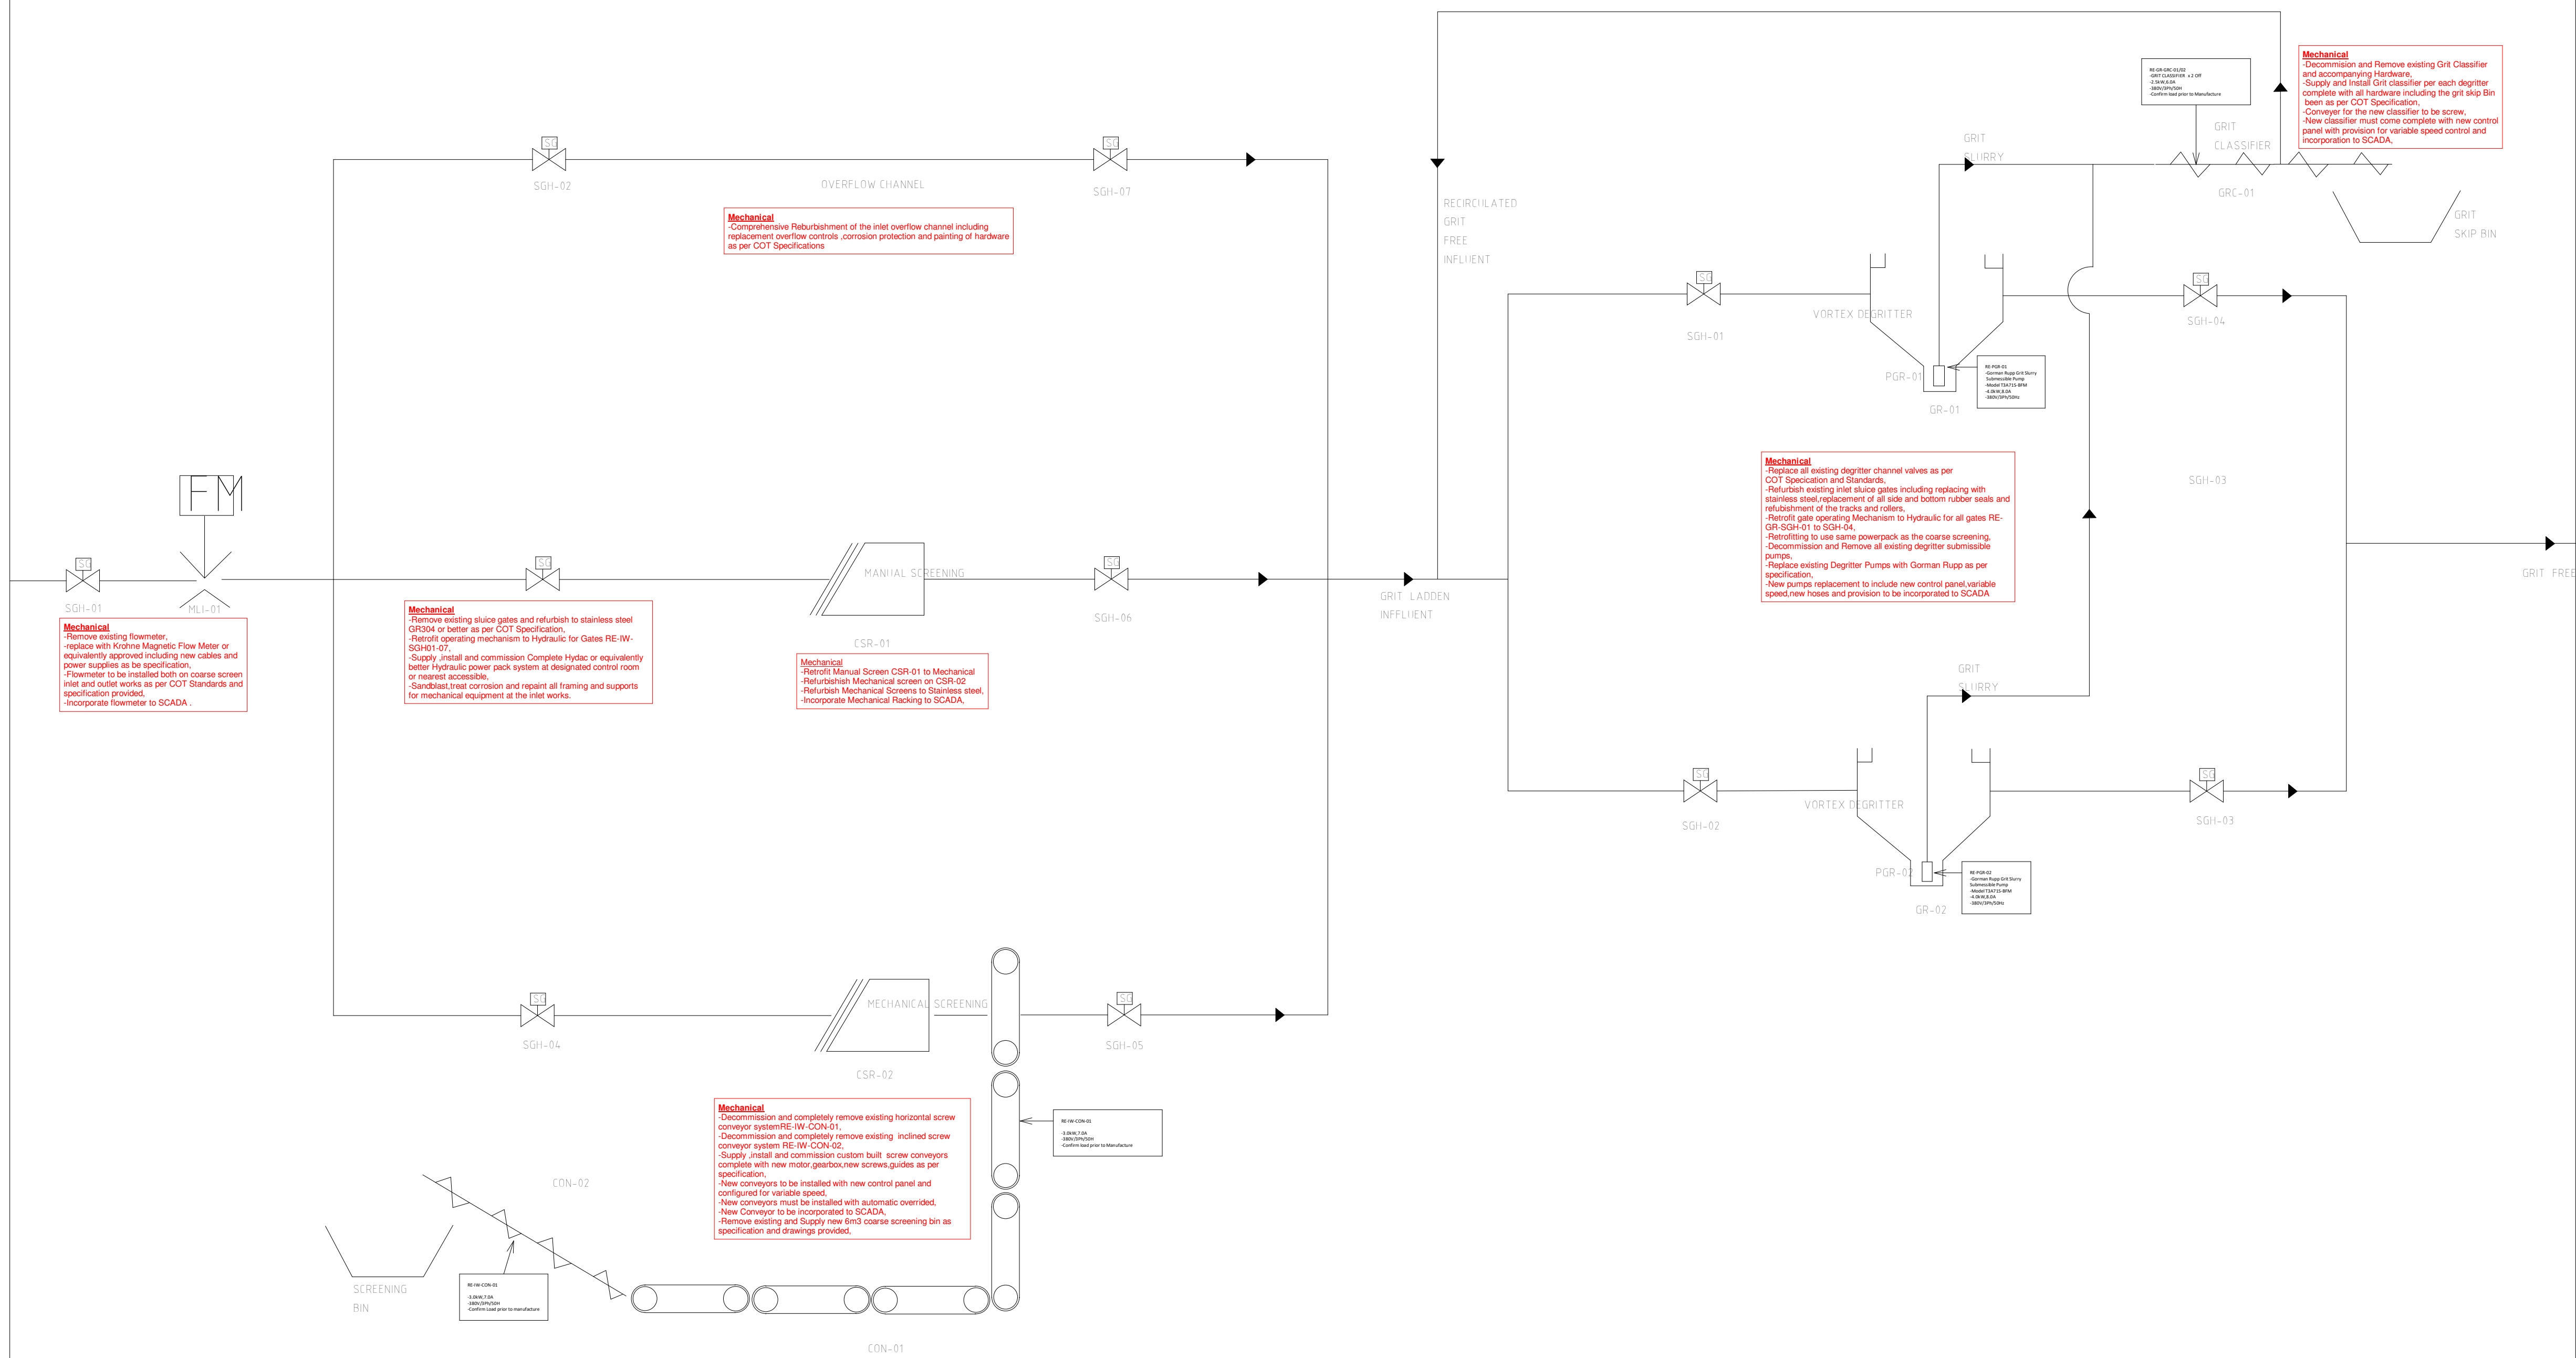

Drawing Notes

No	Date	Revision Description	By
----	------	----------------------	----

DWG.No	ASSOCIATED DRAWING DESCRIPTION
--------	--------------------------------

Client



Development Bank of
South Africa,

1258 Lever Road,
Box 1234 Halfway
House
Headway Hill
Midrand, 1685

+27 11 313 3500
www.dbsa.org

Consultant



Office Unit 6
98 Nagington Road
Waderville
Germiston

Tel: 069 590 1739
Email: mick@analog.co.za

Discipline

MECHANICAL

Service

CITY OF TSHWANE

Drawing Title

ROOIWAL WASTE WATER

Section

EASTWORKS-INLETWORKS

Ref No: Design: D.M

Scale: NTS Drawn: D.G

Date: 01-08-2024 Checked: V.N

Type Number:

PRELIMINARY

Drawing Number: RWWTW-RE-M-IW-01 Rev No: 00