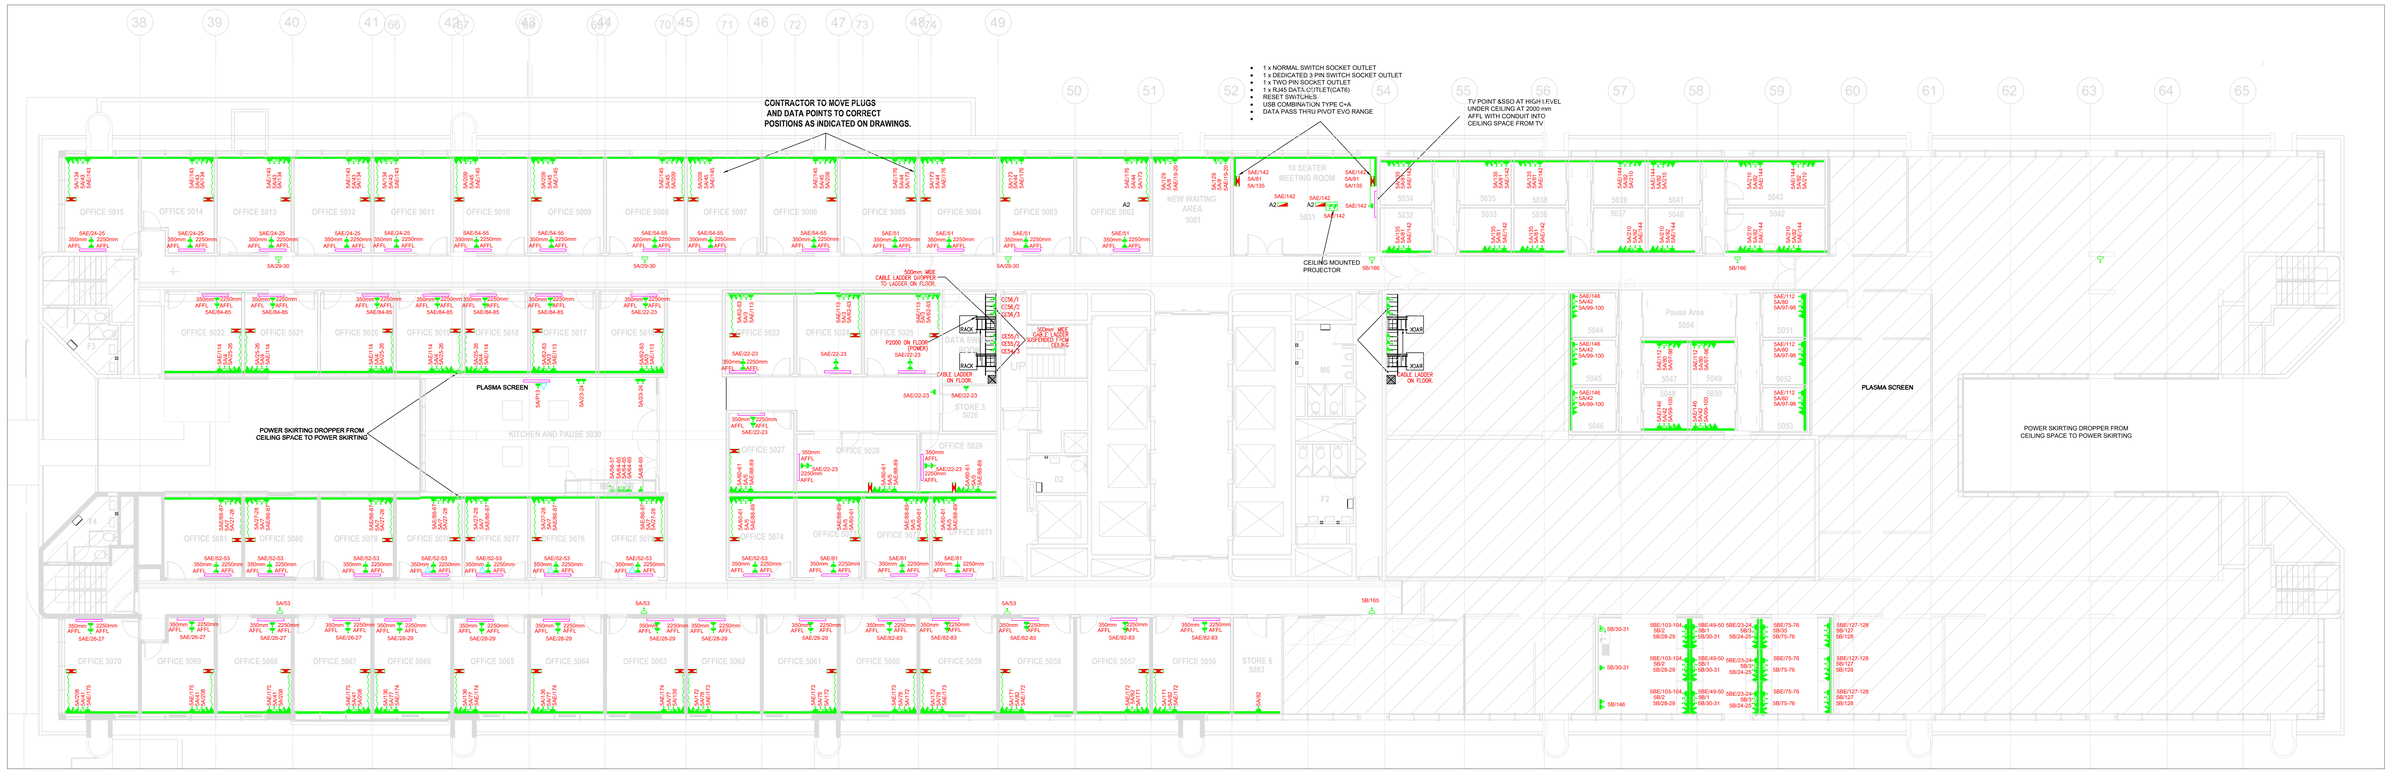

LEGEND

EXISTING 300mm WIDE CABLE LADDER IN CEILING SPACE

EXISTING P8000 TRUNKING IN CEILING SPACE

NEW P8000 TRUNKING IN CEILING SPACE x 190m

NEW 3-COMPARTMENT POWER SKIRTING x 354m

NEW 3-COMPARTMENT POWER SKIRTING
END CAPS X 26

A1 POWER OUTLET AT WORKSTATION CONSIST OF: x 81
- 2 x RESET SWITCH
- 1 x DEDICATED 3 PIN SWITCH SOCKET OUTLET
- 1 x TWO PIN SOCKET OUTLET
- 1 x RJ45 DATA OUTLET
- 1 x RJ11 TELEPHONE OUTLET
- 1 x CABLE BYPASS MODULE

A2 POWER OUTLET IN MEETING ROOMS CONSIST OF: x 0 (But allow for 2)
- 1 x RESET SWITCH
- 3 x NORMAL 3 PIN SWITCH SOCKET OUTLET
- 1 x TWO PIN SOCKET OUTLET
- 1 x VGA PLUS AUDIO CONNECTOR
- 1 x HDMI COUPLER

TELEPHONE POINT x 101
COMPUTER TERMINAL x 101
DEDICATED SWITCH SOCKET OUTLET x101
NORMAL SWITCH SOCKET OUTLET x 124
ALL MOUNTED ON POWER SKIRTING

INPUT CABLES:
1 x DEDICATED 4,5m LENGTH
1 x NORMAL 4,5m LENGTH

NORMAL 16A SWITCH SOCKET
OUTLET RECESSED IN WALL x 2

SINGLE PHASE ISOLATOR x 2

EXISTING NORMAL 16A SWITCH SOCKET
OUTLET TO BE REPLACE TO SUIT NEW SSO x 12

5A UNSWITCH SOCKET OUTLET WITH 3m CORD x

TV POINT x 2

AS-BUILT
DRAWING

REVISIONS			
No.	DATE	REV.	DESCRIPTION
	11.04.23	A	ISSUED FOR APPROVAL.
	18.04.23	T	ISSUED FOR TENDER.
	29.05.23	I	ISSUED FOR INFORMATION.
	21.06.23	1	ISSUED FOR CONSTRUCTION.
	04.08.23	2	Power skirting and droppers in kitchen areas omitted. Droppers in offices 120 &1152 relocated. Workstations and power skirting added in Meeting Room.
	10.08.23	3	CIRCUITRY SHOWN. DATA SWITCH ROOM PLUGS SHOWN.
	06.12.23	4	AS-BUILT

public works
& infrastructure
Department:
Public Works and Infrastructure
REPUBLIC OF SOUTH AFRICA

DBSA
DEVELOPMENT BANK OF SOUTHERN AFRICA
Building Africa's Prosperity

DESIGN CONSULTANT :
GJA CONSULTING ENGINEERS
398 Albert Road
Saltriver
7925
tel: +27 87821 7179
email: admin@gjact.co.za
DURAPI CONSULTING
Innovation. Value. Excellence

CLIENT
PARLIAMENT
CAPE TOWN
90 PLAIN STREET

PROJECT TITLE
WP A.3.2 DEMOLITION & REMOVAL OF
INTERNAL OFFICE PARTITIONS
90 PLEIN STREET

DRAWING TITLE
5TH FLOOR
POWER LAYOUT

SCALE: 1:100	DESIGNED: J. G.
FIRST ISSUE: MARCH 2023	DRAWN: Y. S.
DATE CHECKED: MARCH 2023	CHECKED BY:
PROJECT NO.: 2322	DRAWING NO.: EL.4
REV.: 4	