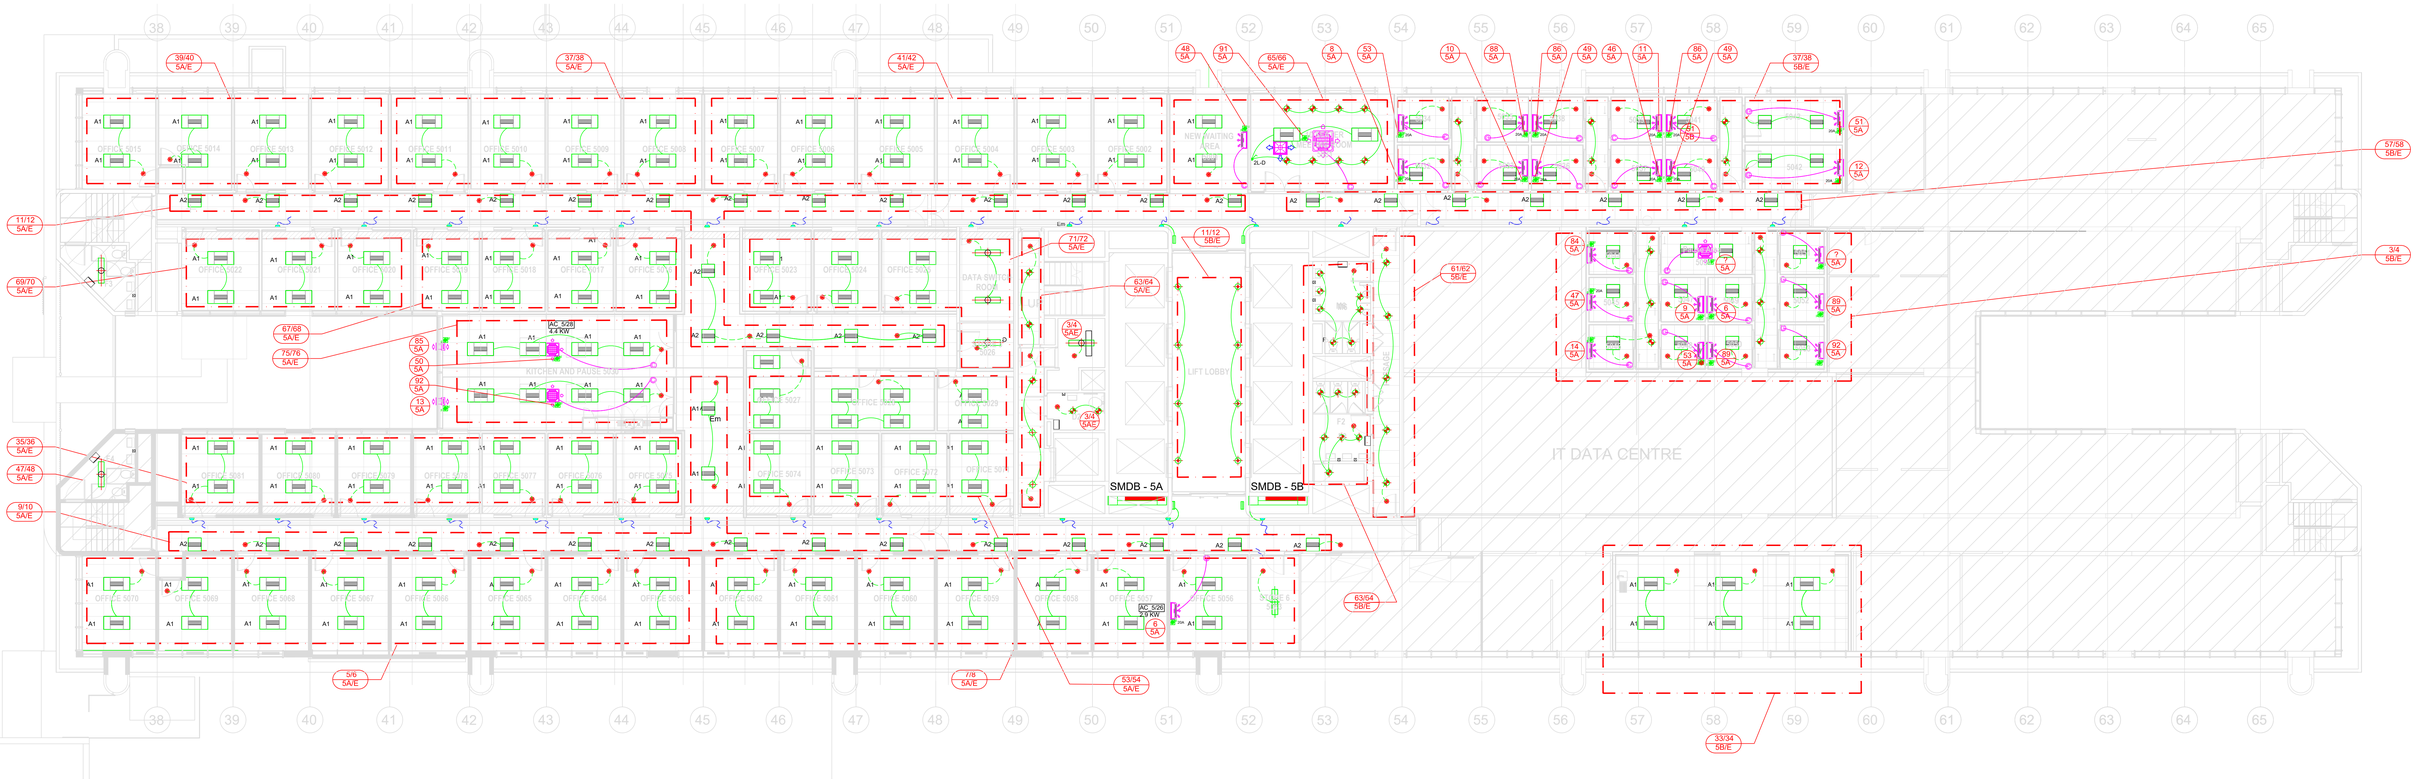

LEGEND

EXISTING P8000 TRUNKING IN CEILING SPACE

NEW P8000 TRUNKING IN CEILING SPACE

A1 — 34W SURFACE MOUNTED 1200x600mm LED EQUIVALENT TO LASCON RCM

A2 — 34W RESECCED 600x600mm WITH LED EQUIVALENT TO LASCON RCM ON

AUTO PRESENCE DETECTOR (SENSOR)

VAPOURPROOF LED SURFACE MOUNTED 1200mm. EQUIVALENT TO LASCON C10

RECESSED LED DOWNLIGHTER

SWITCHING PANEL x 4

100x50mm CONDUIT BOX AT LIGHT SWITCH HEIGHT WITH 20mm Ø TO AC UNIT.

LASCON FUTURA 5 LED 21W WITH FROSTED OPTIC (Cutout size 140 -165 mm)

SINGLE LEVER LIGHT SWITCH

AS - BUILT

REVISIONS		
DATE	REV.	DESCRIPTION
11.04.23	A	ISSUED FOR APPROVAL.
18.04.23	T	ISSUED FOR TENDER.
29.05.23	I	ISSUED FOR INFORMATION.
12.06.23	1	ISOLATORS FOR AC UNITS AND CONDUIT BOXES FOR CONTROLLERS ADDED.
2023.07.18	2	LIGHT FITTINGS CIRCUITED.
2023.07.19	3	LIGHT LAYOUT IN MEETING ROOM, LIFT LOBBY & PASSAGES ALTERED.
2023.08.04	4	60A ISOLATORS IN KITCHEN AREAS CHANGE TO 20A
2023.08.07	5	LIGHTING LAYOUT IN LIFT FOYER ALTERED.
2023.08.09	6	LIGHTING LAYOUT IN AREA BETWEEN GRIDLINES 57-60 + SENSORS ADDED
2023.11.21	7	AS BUILT

public works & infrastructure
Department:
Public Works and Infrastructure
REPUBLIC OF SOUTH AFRICA

DBSA
DEVELOPMENT BANK OF SOUTHERN AFRICA
Building Africa's Prosperity

DESIGN CONSULTANT :

GJA CONSULTING ENGINEERS
398 Albert Road
Saltriver
7925
tel: +27 87821 7179
email: admin@gjact.co.za

DURAPI CONSULTING
Innovation. Value. Excellence

CLIENT
PARLIAMENT
CAPE TOWN
90 PLAIN STREET

PROJECT TITLE
WP A.3.2 DEMOLITION & REMOVAL OF INTERNAL OFFICE PARTITIONS
90 PLEIN STREET

DRAWING TITLE
5TH FLOOR
LIGHTING LAYOUT

SCALE: 1:100	DESIGNED: J. G.
FIRST ISSUE: MARCH 2023	DRAWN: Y. S.
DATE CHECKED: MARCH 2023	CHECKED BY:
PROJECT NO.: 2322	DRAWING NO.: EL.3
	REV.: 7